4656601190

IREDELL COUNTY HEALTH DEPARTMENT

STATESVILLE 704-878-5305 MOORESVILLE 704-664-5281

IMPROVEMENT PERMIT / CERTIFICATE OF COMPLETION / OPERATION PERMIT / EXISTING SYSTEM INSPECTION

PROPERTY DESCRIPTION NO. 15618 DATE DEC 29 1992 TAX MAP NO. 1D-A-21 Watershed: ☐ Yes ☐ No

OWNER OR CONTRACTOR F.J. ERWIN PHONE: Business _____ Home 664-5418

ADDRESS RT 11 Box 190 Mooresville NC 28115

LOCATION 115 South, TL Mackwood Rd, TR Saddle Rd ~1/4 mile on left

SUBDIVISION — BLOCK / SECTION — LOT — LOT AREA ~1/2A SITE CLASS. P DESIGN FLOW 360 L.T.A.R. 0.3

Septic Tank: 1000 Gallons; STB 358 Date 9-17-93

Pump Tank: — Gallons; PT — Date —

Pump Make: — Model — Serial No. —

Nitrification Field: No Fields 1 Square Feet 1200 Linear Feet 400

No Lines 4 Trench Width 36" Max Trench Bottom Depth 36" Gravel Depth 12"

☒ New System ☐ Repair System Type: I, II, III, IV, V, VI

System Description: gravity conventional

Repair System Description: gravity PPBPS

Maintenance Agreement Required: ☐ Yes ☐ No

☒ House/Mod. Home No. Bedrooms 3

☐ Mobile Home No. Bathrooms ?

☐ Business No. Employees ____

☐ Other ____

☐ Slab ☐ Crawl Space ☒ Basement w/plumbing ☐ Basement wo/plumbing


Water Supply: ☒ Individual ☐ Community ☐ Public

Comments:

Comments: *drain from retaining wall and gutter down spouts to be diverted away from system.

INITIAL SITE SKETCH

AS BUILT SKETCH

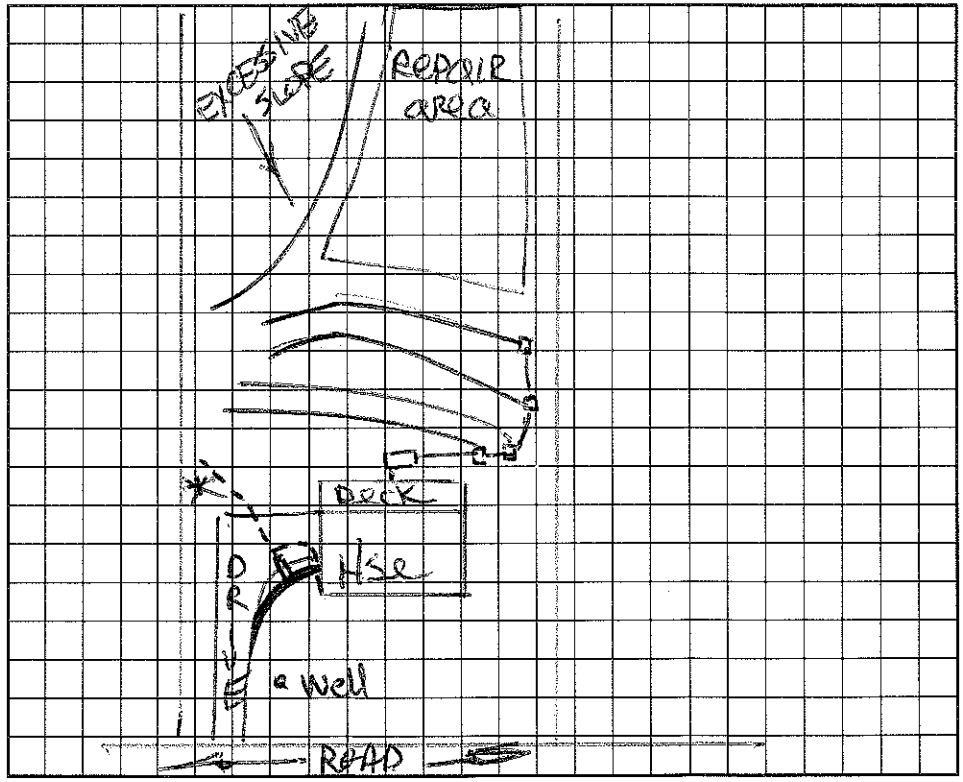

I understand that this permit can be suspended or revoked if any false information is supplied toward securing the permit/any unauthorized changes are made to the site/any unauthorized changes are made in the installation of the system. Improvement Permit is valid for 60 months from date of issuance.

Signed: _____ Installed by: _____

Improvement Permit by: DAVID HINSON date 12-29-92 Certificate of Completion by: Andrea Leman date 10-28-93

Existing System Inspection by: _____ date _____ Operation Permit by: _____ date _____

HEALTH DEPT. COPY: WHITE INSPECTION COPY (FINAL): GREEN OWNER COPY (FINAL): YELLOW INSPECTION COPY (INITIAL): PINK OWNER COPY (INITIAL): GOLD