4656600 3556

IREDELL COUNTY HEALTH DEPARTMENT

STATESVILLE 704-878-5305 MOORESVILLE 704-664-5281

IMPROVEMENT PERMIT / CERTIFICATE OF COMPLETION / OPERATION PERMIT / EXISTING SYSTEM INSPECTION

PROPERTY DESCRIPTION NO. Repair DATE 5/19/95 TAX MAP NO. N/A Watershed: ☐ Yes ☒ No

OWNER OR CONTRACTOR Bud Austin PHONE: Business _____ Home 663-2607

ADDRESS Saddle ~~Mackwood~~ Rd. Mooresville, NC.

LOCATION Mackwood TR on Saddle to 1st house on L past FJS lot

SUBDIVISION _____ BLOCK / SECTION _____ LOT _____ LOT AREA Existing SITE CLASS. _____ DESIGN FLOW _____ L.T.A.R. _____

Septic Tank: Existing Gallons; STB _____ Date _____

Pump Tank: _____ Gallons; PT _____ Date _____

Pump Make: _____ Model _____ Serial No. _____

Nitrification Field: No Fields 1 Square Feet 1200 Linear Feet 400

No Lines 5 Trench Width 36" Max Trench Bottom Depth 36" Gravel Depth 12"

☐ New System ☒ Repair System Type: I, II, III, IV, V, VI

System Description: Repair Conventional

Repair System Description: _____

Maintenance Agreement Required: ☐ Yes ☒ No

☒ House/Mod. Home No. Bedrooms 3

☐ Mobile Home No. Bathrooms 1

☐ Business No. Employees _____

☐ Other _____

☐ Slab ☐ Crawl Space ☒ Basement w/plumbing ☐ Basement wo/plumbing


Water Supply: ☒ Individual ☐ Community ☐ Public

Comments:

Comments:

129 Saddle Rd.

INITIAL SITE SKETCH P/L

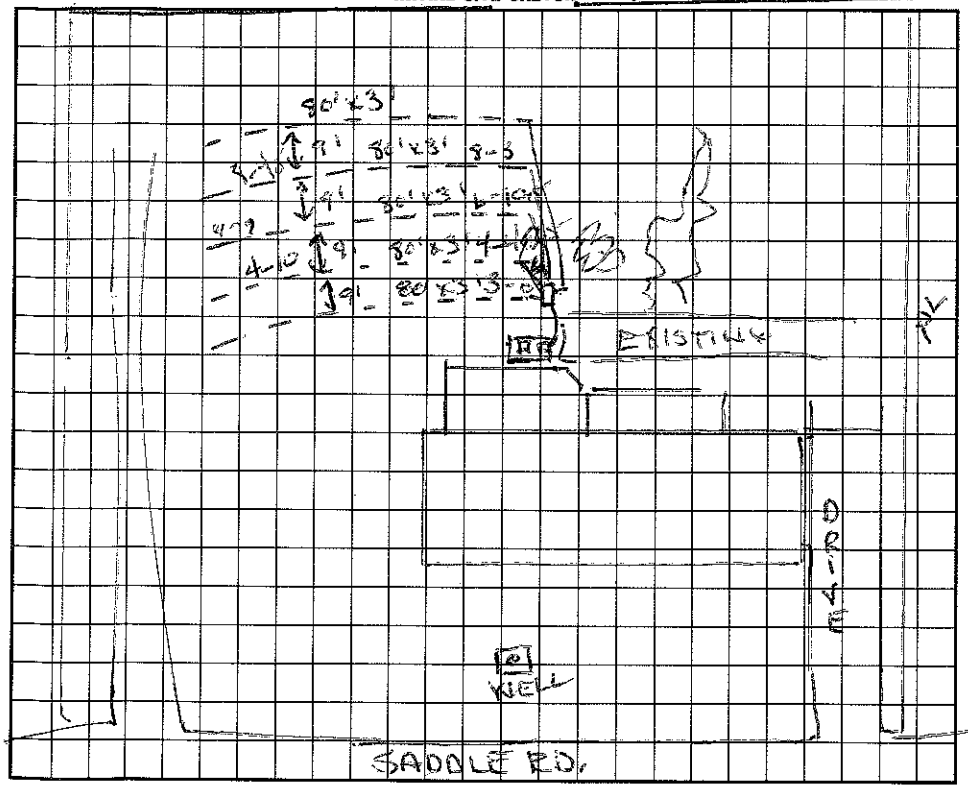

AS BUILT SKETCH

I understand that this permit can be suspended or revoked if any false information is supplied toward securing the permit/any unauthorized changes are made to the site/any unauthorized changes are made in the installation of the system. Improvement Permit is valid for 60 months from date of issuance.

Signed: _____

Improvement Permit by: Wesley Sparks R.S. date 5/19/95

Existing System Inspection by: _____ date _____

Installed by: F.J. Ervin

Certificate of Completion by: _____ date _____

Operation Permit by: Wesley Sparks R.S. date 3/27/96

HEALTH DEPT. COPY: WHITE INSPECTION COPY (FINAL): GREEN OWNER COPY (FINAL): YELLOW INSPECTION COPY (INITIAL): PINK OWNER COPY (INITIAL): GOLD