IREDELL COUNTY HEALTH DEPARTMENT

AUTHORIZATION TO CONSTRUCT

2.00-230

STATESVILLE 704-878-5305 MOORESVILLE 704-664-5281

IMPROVEMENT PERMIT / ~~CERTIFICATE OF COMPLETION~~ / OPERATION PERMIT / EXISTING SYSTEM INSPECTION

PROPERTY DESCRIPTION NO. 25556 DATE 3/19/97 TAX MAP NO. 10-A-62 Watershed: ☐ Yes ☐ No

OWNER OR CONTRACTOR JAN PARSON PHONE: Business 4656605160 Home 895-3562

ADDRESS 103 SOULE LN MOORESVILLE NC 28115

LOCATION 115 S. TL MACKWOOD TR C&L LANE AT END

SUBDIVISION — BLOCK / SECTION — LOT — LOT AREA — SITE CLASS. PS DESIGN FLOW 360GPD L.T.A.R. 360/FP

Septic Tank: 1000 Gallons; STB 794 Date 8/27/97

Pump Tank: — Gallons; PT — Date —

Pump Make: — Model — Serial No. —

Nitrification Field: No Fields 1 Square Feet 1200 Linear Feet 400

No Lines 6@67' Trench Width 36" Max Trench Bottom Depth 26" Gravel Depth 12"

☑ New System ☐ Repair System Type: I, II, III, IV, V, VI

System Description: GRAVITY CONVENTIONAL

Repair System Description: STUB

Maintenance Agreement Required: ☐ Yes ☑ No

☑ House/Mod. Home No. Bedrooms 3

☐ Mobile Home No. Bathrooms 2

☐ Business No. Employees —

☐ Other —

☐ Slab ☑ Crawl Space ☑ Basement w/plumbing ☐ Basement wo/plumbing


Water Supply: ☑ Individual ☐ Community ☐ Public

Comments: FINAL COMPLETION OF SYSTEM TO BE HELD UNTIL PROPER ABANDONMENT OF WELL IS OBTAINED


Comments:

PUSH SYSTEM BACK TO ACCOMM FOR DRIVE

INITIAL SITE SKETCH 1"=60'

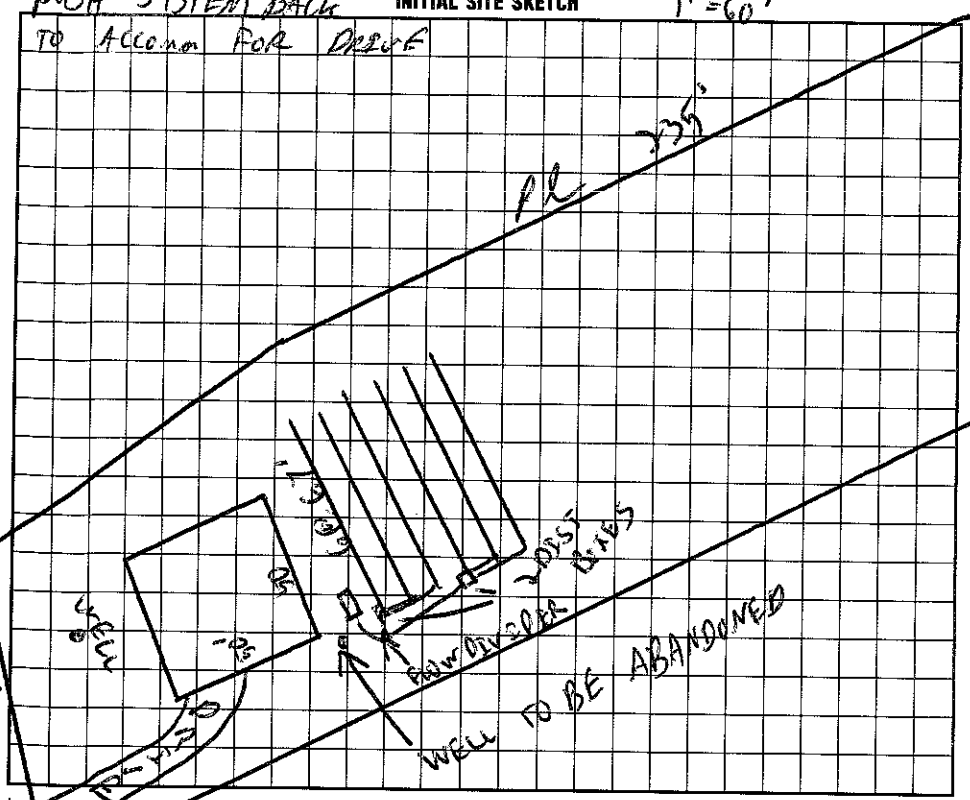

AS BUILT SKETCH

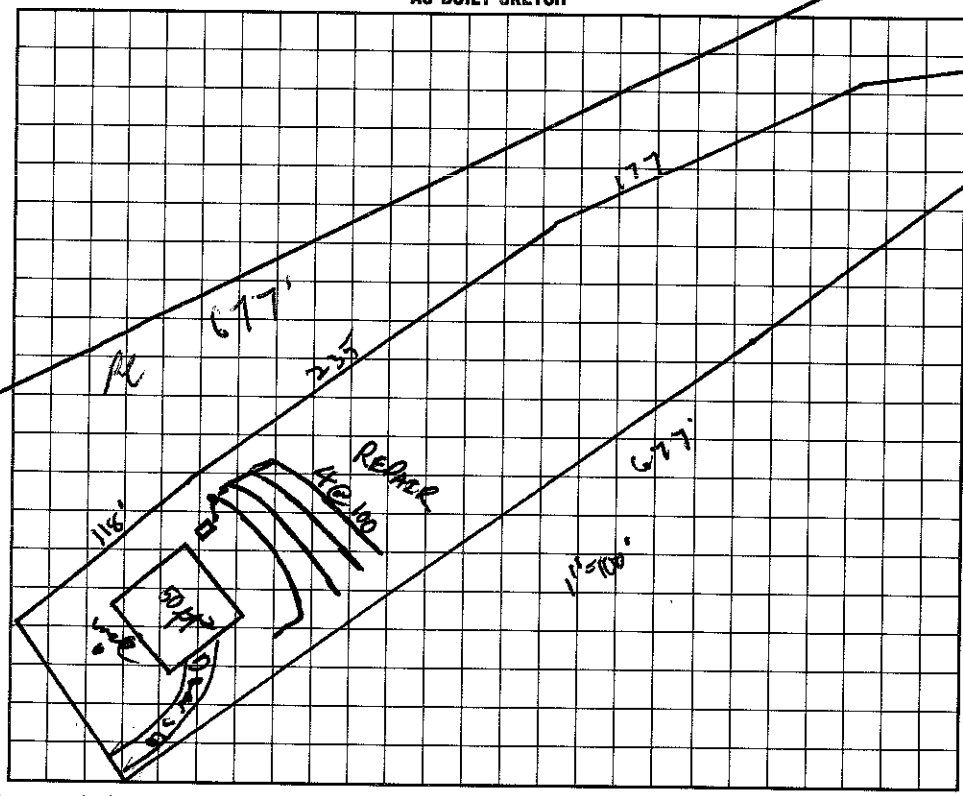

I understand that this permit can be suspended or revoked if any false information is supplied toward securing the permit/any unauthorized changes are made to the site/any unauthorized changes are made in the installation of the system. Improvement Permit is valid for 60 months from date of issuance.

Signed: Jan K. Parson

Improvement Permit by: C. [signature] date 3/19/97

~~Existing System Inspection~~ AUTHORIZATION TO CONSTRUCT by: C. [signature] date 3/19/97

Installed by: FS ERVIN

Certificate of Completion by: — date —

Operation Permit by: C. [signature] date 12/13/97

HEALTH DEPT. COPY: WHITE INSPECTION COPY (FINAL): GREEN OWNER COPY (FINAL): YELLOW INSPECTION COPY (INITIAL): PINK OWNER COPY (INITIAL): GOLD