4695616715

# IREDELL COUNTY HEALTH DEPARTMENT

STATESVILLE 704-878-5305 MOORESVILLE 704-664-5281

## IMPROVEMENT PERMIT / CERTIFICATE OF COMPLETION / OPERATION PERMIT / EXISTING SYSTEM INSPECTION

PROPERTY DESCRIPTION NO. 3218 DATE 3/27/95 TAX MAP NO. 1D1A-A-34 Watershed: ☐ Yes ☑ No

OWNER OR CONTRACTOR Chad Ervin PHONE: Business _____ Home 663-3175

ADDRESS 129 Mackwood Ervin Farm Ln.

LOCATION Mackwood Rd off 1153, TL at brick mailbox to end of cul-de-sac (2)

SUBDIVISION _____ BLOCK / SECTION _____ LOT _____ LOT AREA _____ SITE CLASS. _____ DESIGN FLOW _____ L.T.A.R. _____

Septic Tank: 1000 Gallons; STB 794 Date 2/13/94

Pump Tank: _____ Gallons; PT _____ Date _____

Pump Make: _____ Model _____ Serial No. _____

Nitrification Field: No Fields 1 Square Feet 800 Linear Feet 270

No Lines 4 Trench Width 36" Max Trench Bottom Depth 32" Gravel Depth 12"

☑ New System ☐ Repair System Type: I, II, III, IV, V, VI

System Description: CONV - DIST BOX

Repair System Description: SAME

Maintenance Agreement Required: ☐ Yes ☐ No

☑ House/Mod. Home No. Bedrooms 2

☐ Mobile Home No. Bathrooms 2.5

☐ Business No. Employees ____

☐ Other _____


☐ Slab ☑ Crawl Space ☐ Basement w/plumbing ☐ Basement wo/plumbing

Water Supply: ☑ Individual ☐ Community ☐ Public Firefighters

Comments:

Comments:

**INITIAL SITE SKETCH**

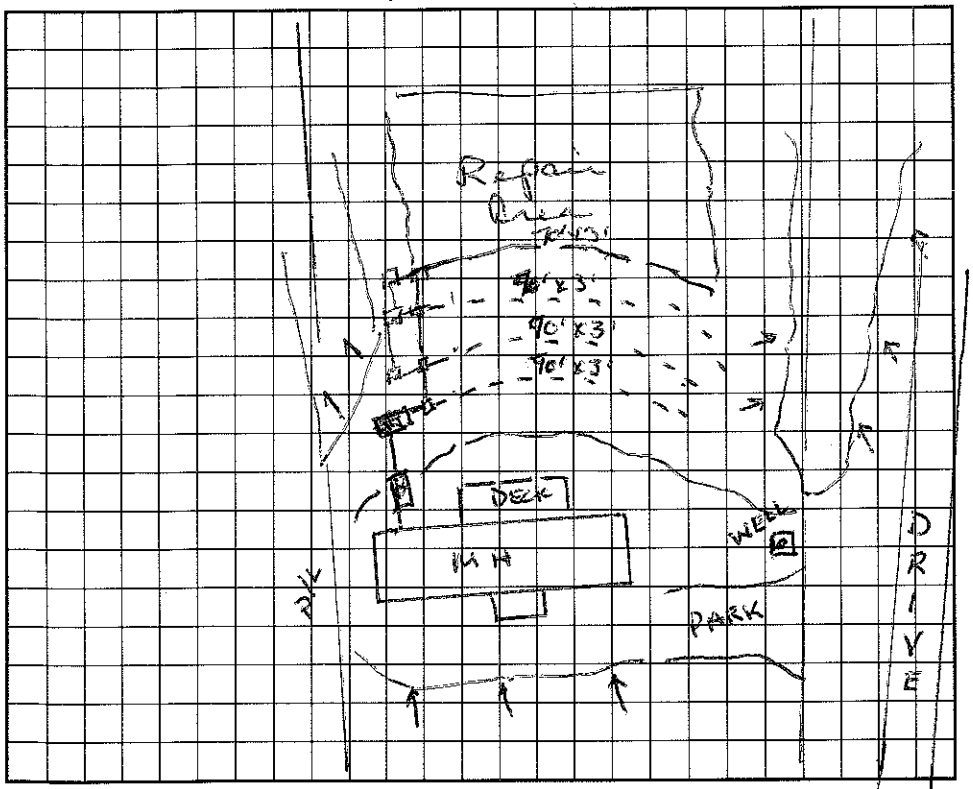


**AS BUILT SKETCH**

I understand that this permit can be suspended or revoked if any false information is supplied toward securing the permit/any unauthorized changes are made to the site/any unauthorized changes are made in the installation of the system. Improvement Permit is valid for 60 months from date of issuance.

Signed: Chad W. Ervin

Improvement Permit by: Wesley Sparks RS. date 3/27/95

Existing System Inspection by: _____ date _____

Installed by: T J Ervin

Certificate of Completion by: Wesley Sparks RS date 3/29/95

Operation Permit by: _____ date _____

HEALTH DEPT. COPY: WHITE INSPECTION COPY (FINAL): GREEN OWNER COPY (FINAL): YELLOW INSPECTION COPY (INITIAL): PINK OWNER COPY (INITIAL): GOLD