IREDELL COUNTY HEALTH DEPARTMENT

STATESVILLE 704-878-5305 MOORESVILLE 704-664-5281

IMPROVEMENT PERMIT / AUTHORIZATION TO CONSTRUCT / OPERATION PERMIT / EXISTING SYSTEM INSPE

PERMIT# MOORESVILLE - 5446 PIN# PT of 4656 62 0900

OWNER OR CONTRACTOR LOUISE BROWN PHONE: Business _____ DATE 5/14/98

ADDRESS 132 STACY RD. MOORESVILLE NC 28115 Home 663-4724

LOCATION HWY 1155 - TL MACKWOOD - TL STACY RD - AT VERY END

SUBDIVISION — BLOCK / SECTION — LOT — LOT AREA ~6 AC SITE CLASS. PS

Septic Tank: 1000 Gallons; STB 1012 Date 11/7/97 DESIGN FLOW 240GPD L.T.A.R. 3 BED/EST

Pump Tank: _____ Gallons; PT _____ Date _____

Pump Make: _____ Model _____ Serial No. _____

Nitrification Field: No Fields 1 Square Feet 804 Linear Feet 268

No Lines 4@67 Trench Width 36" Max Trench Bottom Depth 36" Gravel Depth 12"

☑ New System ☐ Repair System Type: I (II) III, IV, V, VI

System Description: GRAVITY CONVENTIONAL

Repair System Description: SAME

Maintenance Agreement Required: ☐ Yes ☑ No

☐ House/Mod. Home ☑ Mobile Home ☐ Business ☐ Other

No. Bedrooms 2 No. Bathrooms 2 No. Employees ___

☐ Slab ☑ Crawl Space ☐ Basement w/plumbing ☐ Basement wo/plumbing


Water Supply: ☑ Individual ☐ Public ☐ Community

Comments:/Conditions:


Comments:/Conditions:

FROM NEIGHBOR

INITIAL SITE SKETCH

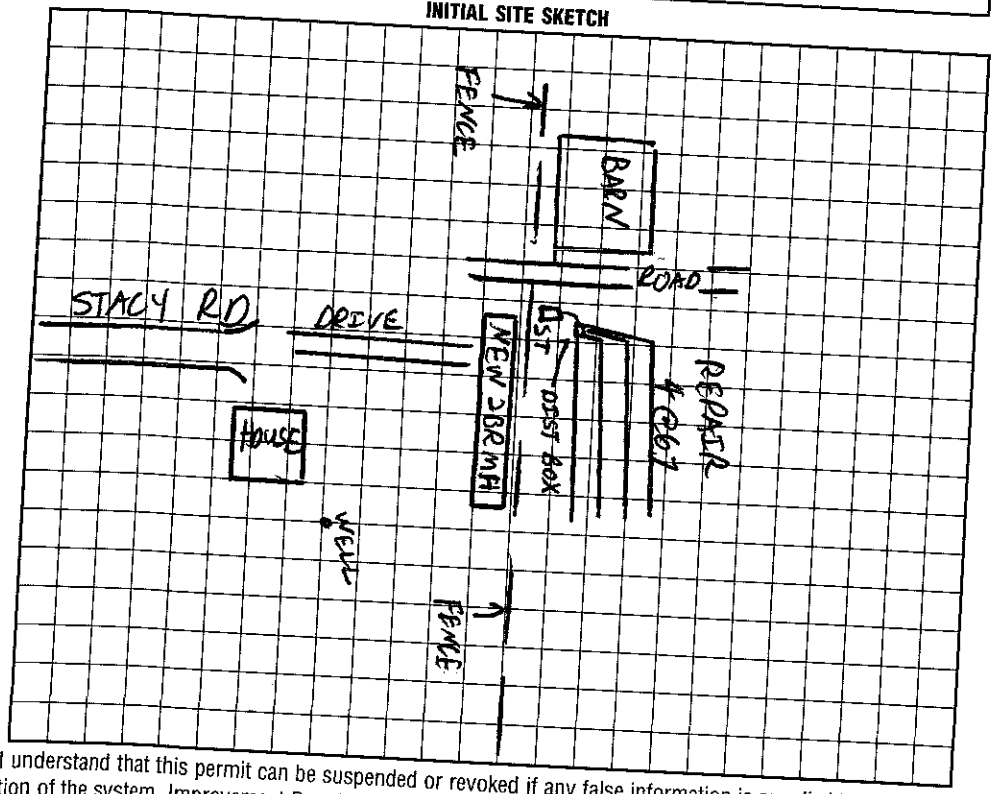

AS BUILT SKETCH

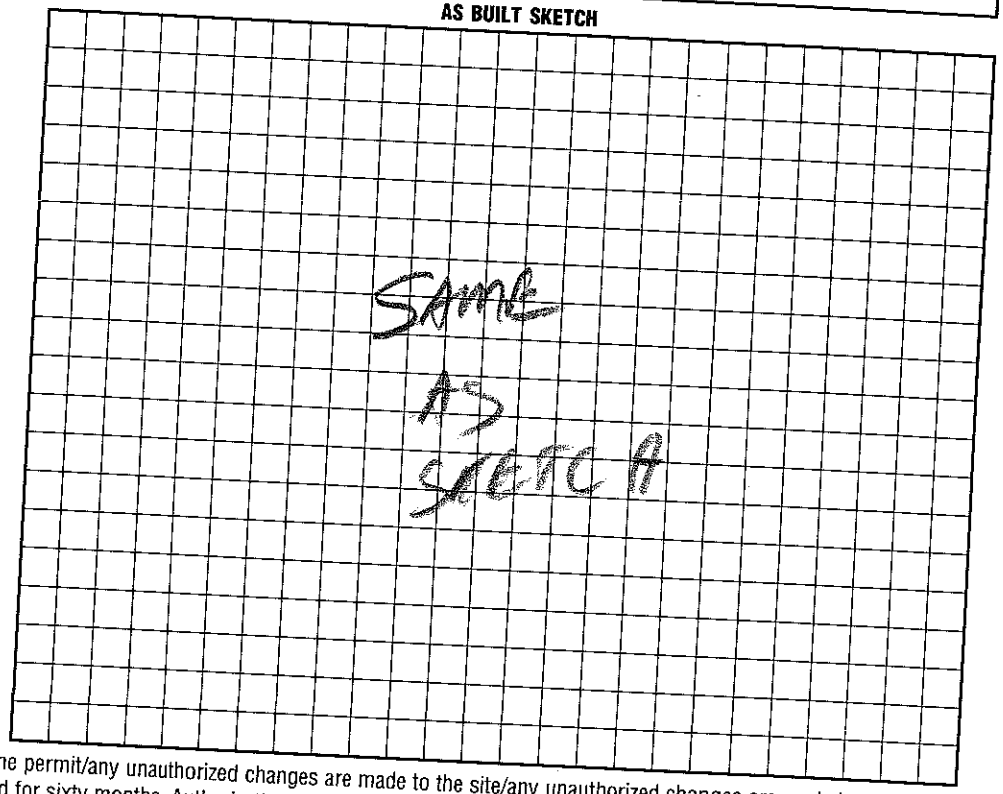

I understand that this permit can be suspended or revoked if any false information is supplied toward securing the permit/any unauthorized changes are made to the site/any unauthorized changes are made in the installation of the system. Improvement Permit with plat valid without expiration. Improvement Permit with site plan valid for sixty months. Authorization to Construct is valid for a period equal to that of Improvement Permit – not to exceed sixty months.

Signed: Louise D. Brown

Improvement Permit by: C. [illegible] RS date 5-15-98

Authorization to Construct by: C. [illegible] RS date 5/14/98

Installed by: Steve Sudan

Operation Permit by: C. [illegible] date 5/14/98

Existing System Inspection by: _____ date 6/3/98

HEALTH DEPT. COPY: WHITE INSPECTION COPY (FINAL): GREEN OWNER COPY (FINAL): YELLOW INSPECTION COPY (INITIAL): PINK OWNER COPY (INITIAL): GOLD