IREDELL COUNTY HEALTH DEPARTMENT

STATESVILLE 704-878-5305 MOORESVILLE 704-664-5281

IMPROVEMENT PERMIT / AUTHORIZATION TO CONSTRUCT / OPERATION PERMIT / EXISTING SYSTEM INSPECTION

PERMIT# Nc PIN# 4656-62-6388 DATE 11/22/00

OWNER OR CONTRACTOR Kenneth Childers PHONE: Business Home 663-2501

ADDRESS Stacie Lane Mooresville, NC.

LOCATION 115 S TL Mailwood TL Stacie Ln 1st white house on (R)

SUBDIVISION No BLOCK / SECTION LOT LOT AREA SITE CLASS. DESIGN FLOW 360 L.T.A.R. .02

Septic Tank: 1000 Gallons; STB Date
Pump Tank: Gallons; PT Date
Pump Make: Model Serial No.
Nitrification Field: No Fields 2 Square Feet 600+600 Linear Feet 360
No Lines 3+3 Trench Width 10' EACH Max Trench Bottom Depth 36" Gravel Depth 12"

☐ New System ☒ Repair System Type: I (II) III, IV, V, VI
System Description:
Repair System Description: 2 Beds each 60' x 10'
Maintenance Agreement Required: ☐ Yes ☒ No

☒ House/Mod. Home No. Bedrooms 3
☐ Mobile Home No. Bathrooms 1
☐ Business No. Employees
☐ Other


☐ Slab ☒ Crawl Space ☐ Basement w/plumbing ☐ Basement wo/plumbing

Water Supply: ☒ Individual ☐ Public ☐ Community

Comments:/Conditions: EXISTING TANK PUMPED EMPTY CRUSHED IN AND FILLED WITH SOIL. NEW TANK SET OVER 50' AWAY FROM WELL. SIZED FOR 50% GREATER FT² FOR BED USE.

Comments:/Conditions:

INITIAL SITE SKETCH

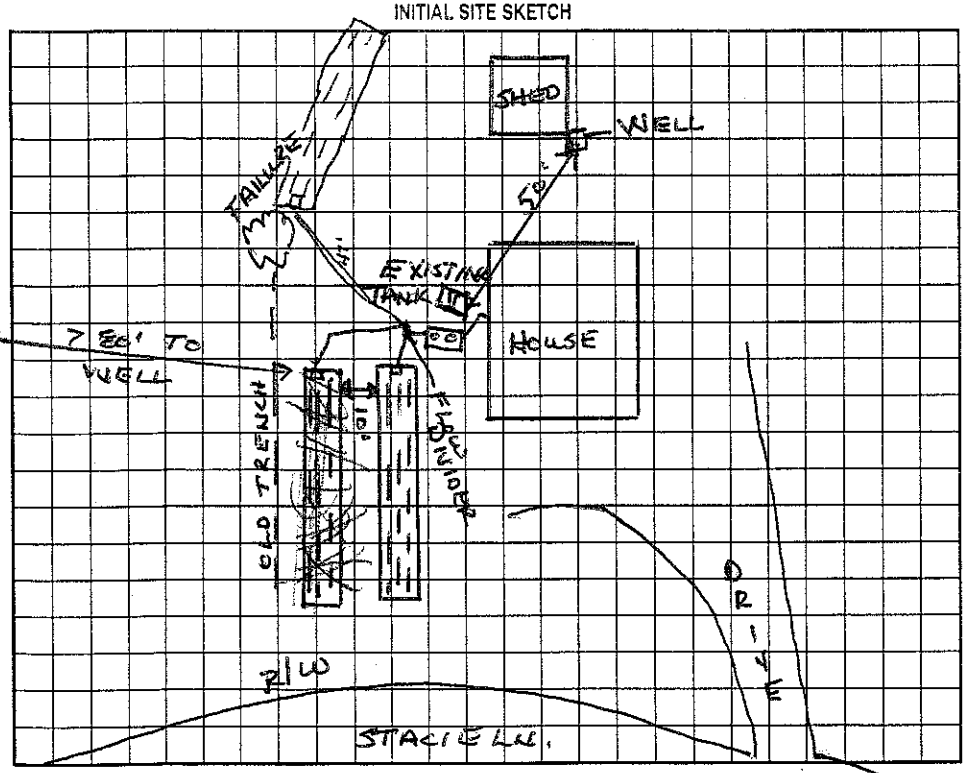

AS BUILT SKETCH

Permit can be suspended or revoked if any false information is supplied toward securing the permit/any unauthorized changes are made to the site/any unauthorized changes are made in the installation of the system. Improvement Permit with plat valid without expiration. Improvement Permit with site plan valid for sixty months. Authorization to Construct is valid for a period equal to that of Improvement Permit – not to exceed sixty months.

Signed: X date

Improvement Permit by: Wesley Sparks RS date 11/22/00

Authorization to Construct by: Wesley Sparks RS date 11/22/00

Installed by: F J Ervin

Operation Permit by: Wesley Sparks RS. date 12/29/00

Existing System Inspection by: date

HEALTH DEPT. COPY: WHITE OWNER COPY (FINAL): YELLOW OWNER COPY (INITIAL): PINK