IREDELL COUNTY HEALTH DEPARTMENT

STATESVILLE 704-878-5305 MOORESVILLE 704-664-5281

IMPROVEMENT PERMIT / AUTHORIZATION TO CONSTRUCT / OPERATION PERMIT / EXISTING SYSTEM INSPECTION

PERMIT# 5815 PIN# ~~4656 94 7943~~ 4656 94 7982 DATE 11/30/98

OWNER OR CONTRACTOR Brian Kalstek PHONE: Business 660-6765 Home

ADDRESS 610 Emerson St. Mooresville, NC. 28115

LOCATION Shearers Rd. TR Clodfelter Rd. to graded lot on (L)

SUBDIVISION N/A BLOCK / SECTION LOT 1 LOT AREA .71Ac SITE CLASS PS DESIGN FLOW 360 L.T.A.R. .3

Septic Tank: 1000 Gallons; STB 794 Date 10/16/98
Pump Tank: Gallons; PT Date
Pump Make: Model Serial No.
Nitrification Field: No Fields 1 Square Feet 900* Linear Feet 300*
No Lines 4 Trench Width 36" Max Trench Bottom Depth 36" Gravel Depth SAND

☒ New System ☐ Repair System Type: I, II, (III), IV, V, VI
System Description: Gravity ch. Plastic
Repair System Description: Pressure - 16" PPBS
Maintenance Agreement Required: ☐ Yes ☒ No

☒ House/Mod. Home No. Bedrooms 3
☐ Mobile Home No. Bathrooms 3
☐ Business No. Employees
☐ Other


☐ Slab ☒ Crawl Space ☐ Basement w/plumbing ☐ Basement wo/plumbing

Water Supply: ☒ Individual ☐ Public ☐ Community

Comments:/Conditions: * 25% reduction given.

Comments:/Conditions:

INITIAL SITE SKETCH

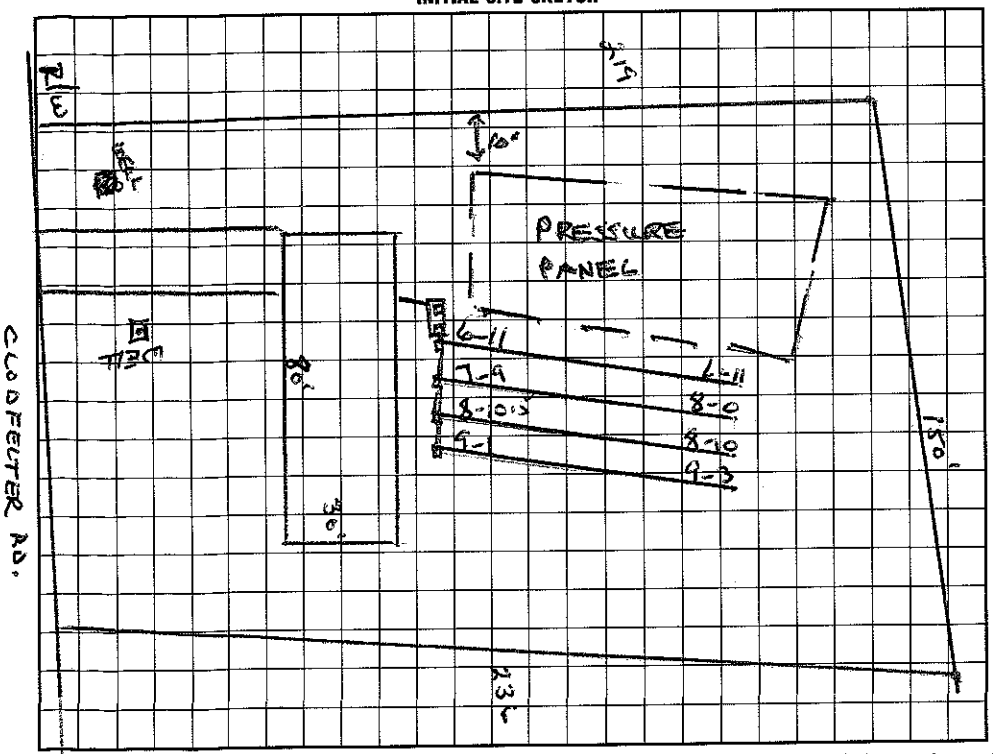

AS BUILT SKETCH

I understand that this permit can be suspended or revoked if any false information is supplied toward securing the permit/any unauthorized changes are made to the site/any unauthorized changes are made in the installation of the system. Improvement Permit with plat valid without expiration. Improvement Permit with site plan valid for sixty months. Authorization to Construct is valid for a period equal to that of Improvement Permit – not to exceed sixty months.

Signed: * BRIAN KALSTEK by W. Sparks date 12/30/98 Installed by: Lavon Benton

Improvement Permit by: Wesley Sparks RS. date 11/30/98 Operation Permit by: Wesley Sparks RS. date 1/27/99

Authorization to Construct by: Wesley Sparks RS. date 11/30/98 Existing System Inspection by: date

HEALTH DEPT. COPY: WHITE INSPECTION COPY (FINAL): GREEN OWNER COPY (FINAL): YELLOW INSPECTION COPY (INITIAL): PINK OWNER COPY (INITIAL): GOLD