DELL COUNTY HEALTH DEPARTMENT

STATESVILLE 704-878-5305 MOORESVILLE 704-664-5281

IMPROVEMENT PERMIT / AUTHORIZATION TO CONSTRUCT / OPERATION PERMIT / EXISTING SYSTEM INSPECTION

PERMIT # Repair PIN # 4657042767 DATE 6-16-2010

OWNER or APPLICANT Tim Bradley Curt PHONE: Business 704 634-5823 Home:

OWNER or APPLICANT ADDRESS

LOCATION / DIRECTIONS Hwy 150 W. TL Talbert TR McAdam on right corner #260

SUBDIVISION BLOCK / SECTION LOT # LOT AREA .45Ac. DESIGN FLOW 360gpd L.T.A.R.

Septic Tank Exist. Gallons: STB Date

Pump Tank Gallons: P T Date

Pump Make Model Serial #

Nitrification Field No Fields 1-2 No Lines 6 Linear Feet ~200Ft

Trench Width 36" Max. Trench Bottom Depth 24" Gravel Depth N/A

☐ New System ☒ Repair ☐ Expansion System Type I II III IV V VI

System Description: Gravity - Conventional

Repair System Description: Gravity - 25% Reduct.

Maintenance Agreement Required ☐ YES ☒ NO

☐ GRAVITY ☐ PRESSURE

☒ Residence No. Bedrooms 3

☐ Business No. Persons

☐ Other No. Employees


☐ Slab ☐ Crawl Space

☐ Basement w/plumbing ☐ Basement w/o plumbing

Water Supply: ☐ Private ☐ Public ☐ Community


Comments / Conditions: Install New drainlines directly behind house, use Serial distribution & feed New drainlines first then feed into old lines.

INITIAL SITE SKETCH

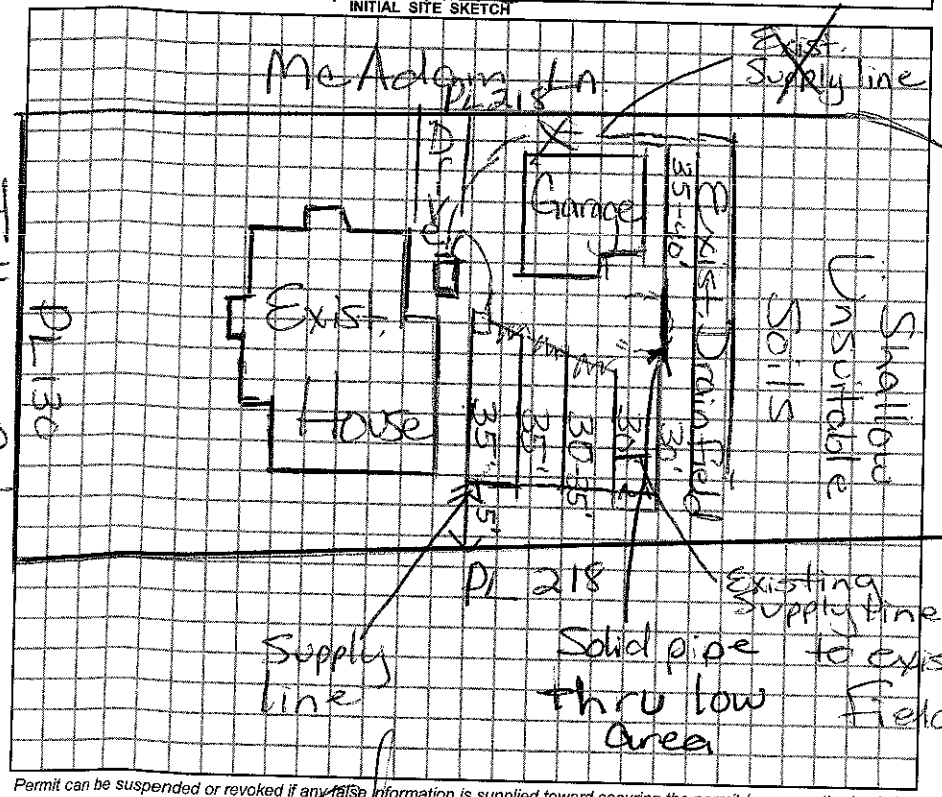

Comments / Conditions: Keep Drainfield at least 5Ft from Pl & 5Ft from House & Garage. Keep drainfield Shallow. Solid pipe thru low area. If Septic Tank is not structurally sound may have to be replaced. ST was pumped 6/18/2010 Installed Plastic Chambers BIOA36

AS BUILT SKETCH

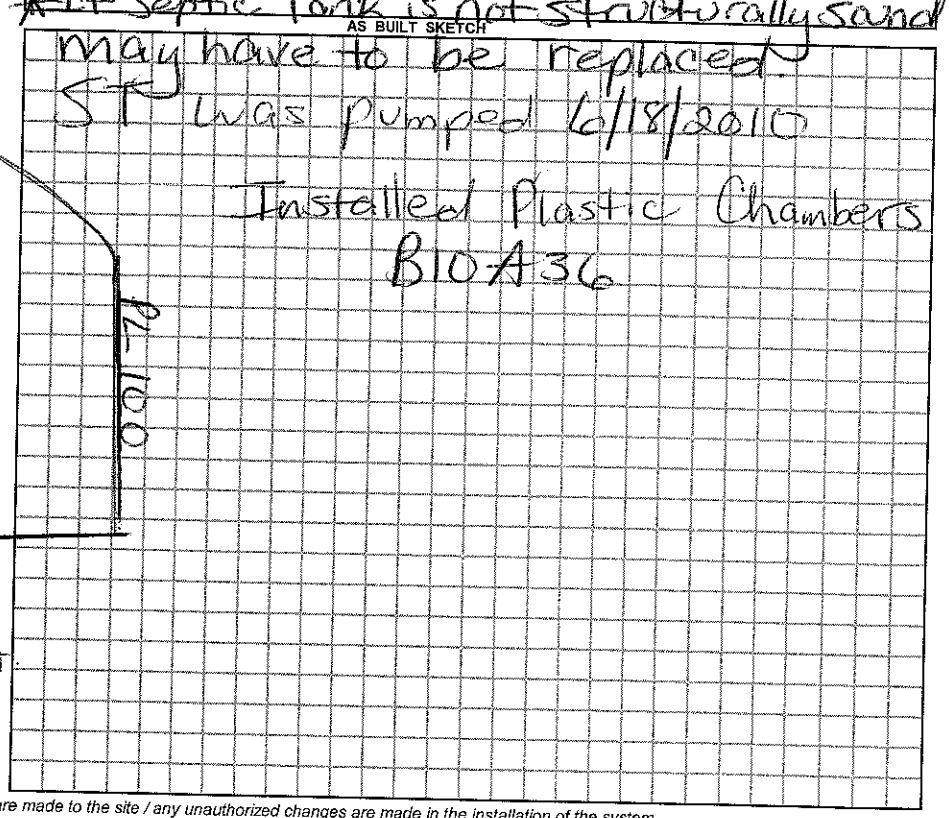

Permit can be suspended or revoked if any false information is supplied toward securing the permit / any unauthorized changes are made to the site / any unauthorized changes are made in the installation of the system.

☐ IMPROVEMENT PERMIT w / plat valid without expiration. ☐ IMPROVEMENT PERMIT w / site plan valid for 60 mos. ☐ AUTHORIZATION TO CONSTRUCT valid for period equal to IMPROVEMENT PERMIT-not to exceed 60 mo.

Owner / Applicant Signature: Date 6-17-10

Improvement Permit by: Repair RELS Date 6/16/2010

Authorization to Construct by: Date 6/16/2010

Installed by: Curt Dunning RELS

Operation Permit by: Date: 6/18/2010

Existing System Inspected by: Date:

YOU SHOULD CONTACT A LOCATOR SERVICE PRIOR TO ANY EXCAVATION.

WHITE COPY Environmental Health YELLOW COPY (Final) Owner / Applicant PINK COPY (Initial) Owner / Applicant