4657053094

IREDELL COUNTY HEALTH DEPARTMENT

STATESVILLE 704-878-5305 MOORESVILLE 704-664-5281

IMPROVEMENT PERMIT / CERTIFICATE OF COMPLETION / OPERATION PERMIT / EXISTING SYSTEM INSPECTION

PROPERTY DESCRIPTION NO. Mooresville #3675 DATE 1/27/95 TAX MAP NO. 2J2-A-19 Watershed: ☐ Yes ☐ No

OWNER OR CONTRACTOR Frank Smith PHONE: Business 663-3770 Home

ADDRESS 246 Talbert Road Mooresville

LOCATION 150 W, L on Talbert, 200 on Rt

SUBDIVISION BLOCK / SECTION LOT LOT AREA SITE CLASS. DESIGN FLOW L.T.A.R.

Septic Tank: Existing Gallons; STB Date

Pump Tank: Gallons; P/T Date

Pump Make: Model Serial No.

Nitrification Field: No Fields Square Feet Linear Feet

No Lines Trench Width Max Trench Bottom Depth Gravel Depth

☐ New System ☐ Repair System Type: I. II. III. IV. V. VI

System Description: Existing

Repair System Description:

Maintenance Agreement Required: ☐ Yes ☐ No

☐ Slab ☐ Crawl Space ☐ Basement w/plumbing ☐ Basement wo/plumbing

☐ House/Mod. Home No. Bedrooms

☐ Mobile Home No. Bathrooms

☑ Business No. Employees

☐ Other

Water Supply: Private Well

☐ Community


☐ Public

Comments:

Comments: Minimize traffic over system area!!

INITIAL SITE SKETCH

AS BUILT SKETCH

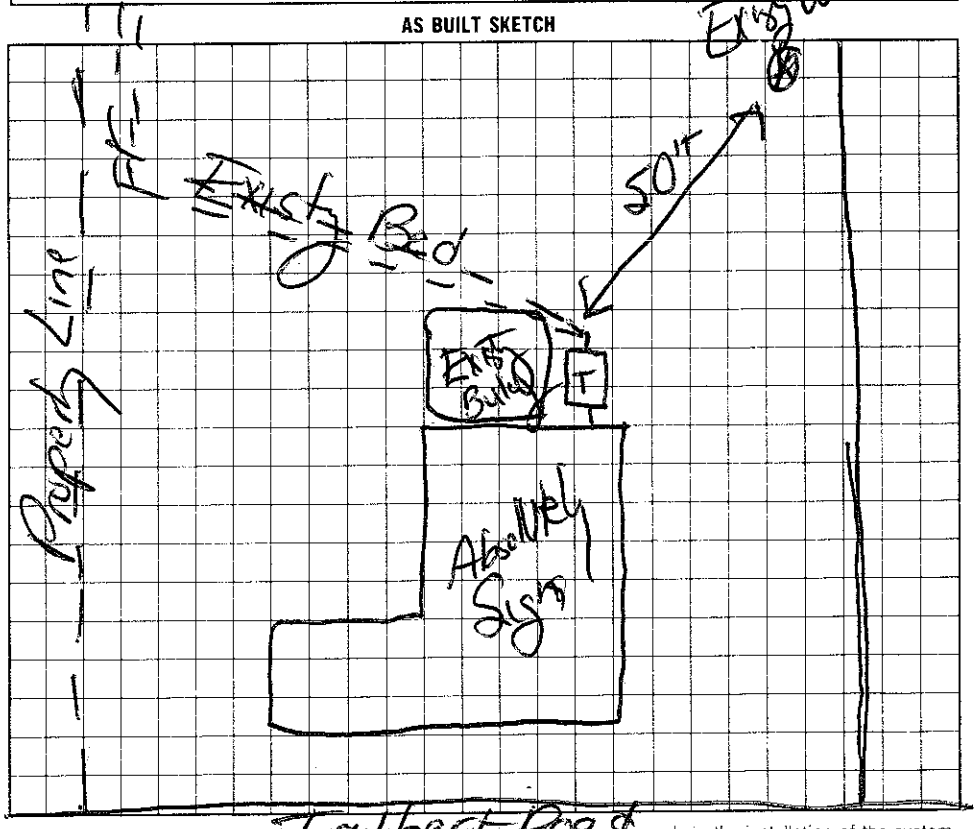

I understand that this permit can be suspended or revoked if any false information is supplied toward securing the permit/any unauthorized changes are made to the site/any unauthorized changes are made in the installation of the system.

Signed:

Improvement Permit by: date

~~Existing System~~ Inspection by: date

Installed by:

Certificate of Completion by: date

~~Operation~~ Permit by: Existing System Inspection By date 1/27/95

HEALTH DEPT. COPY: WHITE INSPECTION COPY (FINAL): GREEN OWNER COPY (FINAL): YELLOW INSPECTION COPY (INITIAL): PINK OWNER COPY (INITIAL): GOLD