4657186329

IREDELL COUNTY HEALTH DEPARTMENT

STATESVILLE 704-878-5305 MOORESVILLE 704-664-5281

IMPROVEMENT PERMIT / AUTHORIZATION TO CONSTRUCT / OPERATION PERMIT / EXISTING SYSTEM INSPECTION

PERMIT# Repair PIN# DATE 10/31/07

OWNER OR APPLICANT C H JOHNSON PHONE: Business Home 704-663-2378

ADDRESS 189 Oates Rd. Mooresville, NC. 28115

LOCATION 1.5 OW TR Talbert Rd. TR on (R) first brick house on (R)

SUBDIVISION NA BLOCK / SECTION LOT LOT AREA EXISTING SITE CLASS. DESIGN FLOW 360 L.T.A.R.

Septic Tank: 1000 Gallons: STB 1012 Date 5-3-07
Pump Tank: Gallons: PT Date
Pump Make: Model Serial No.
Nitrification Field: No Fields Square Feet Linear Feet
No Lines Trench Width EXISTING Max Trench Bottom Depth Gravel Depth ☐ Gravity ☐ Pressure

☐ New System ☒ Repair ☐ Expansion System Type: I (II) III IV V VI
System Description: Add NEW SEPTIC TANK
Repair System Description:
Maintenance Agreement Required: ☐ Yes ☐ No

☒ House/Mod. Home No. Bedrooms 3
☐ Mobile Home No. Persons
☐ Business No. Employees
☐ Other


Water Supply: ☒ Individual ☐ Public ☐ Community

☐ Slab ☒ Crawl Space ☐ Basement w/plumbing ☐ Basement wo/plumbing


Comments:/Conditions: Replacing old Septic Tank with new 1000 gal. Septic Tank & Add Poly Lock FILTER IN NEW ST & CONNECT TO EXISTING BED. OLD TANK PUMPED, CRUSHED, AND BURIED ON SITE.

Comments:/Conditions:

INITIAL SITE SKETCH

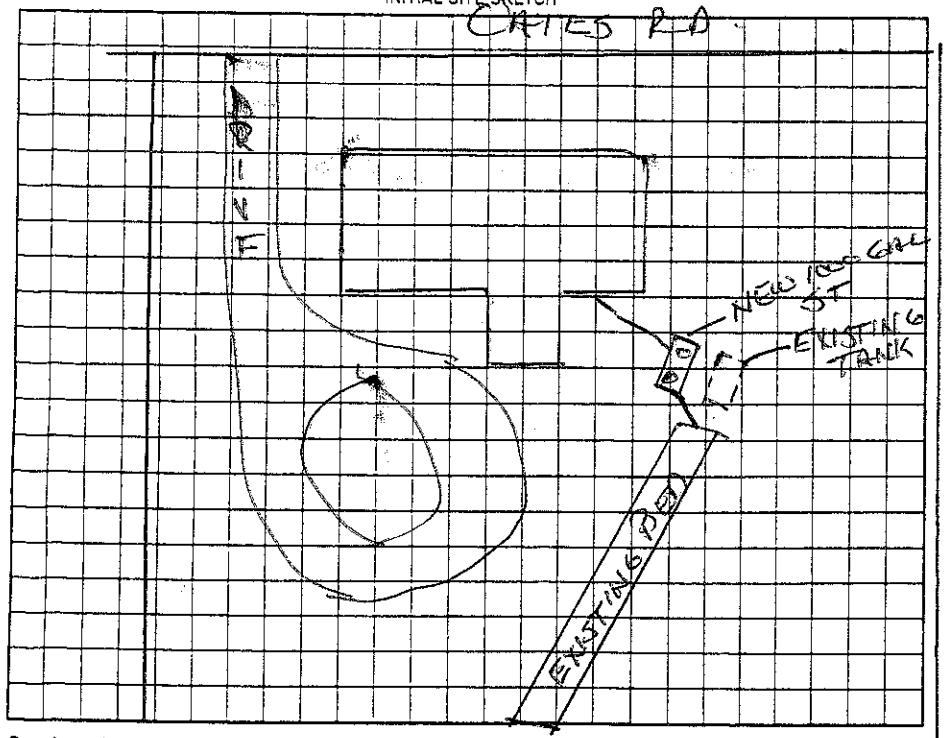

AS BUILT SKETCH

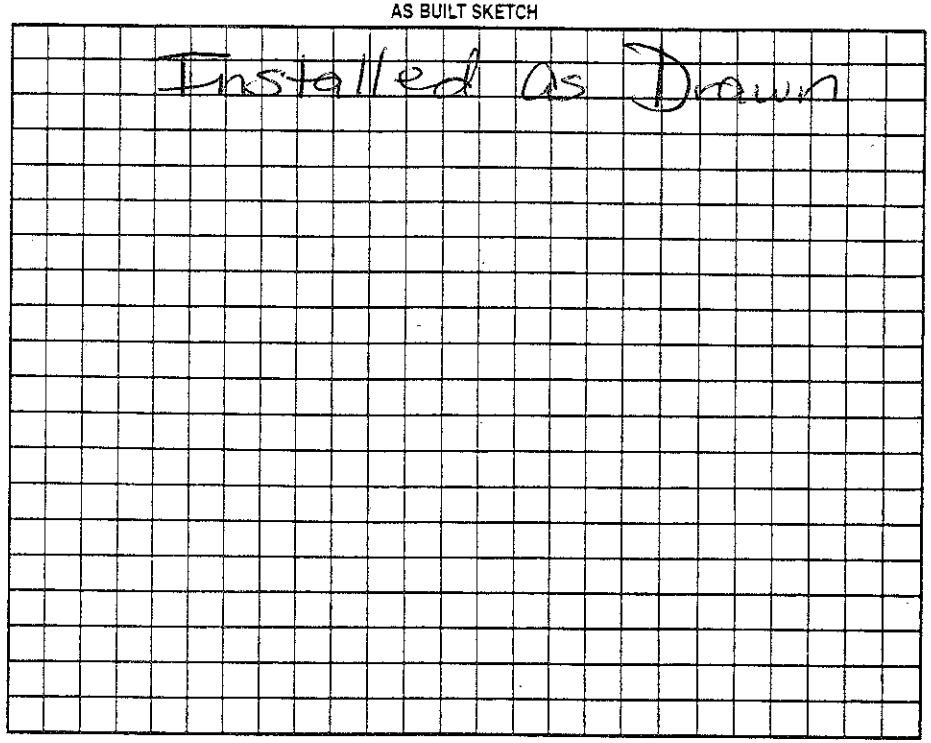

Permit can be suspended or revoked if any false information is supplied toward securing the permit/any unauthorized changes are made to the site/any unauthorized changes are made in the installation of the system. Improvement Permit with plat valid without expiration ☐ Improvement Permit with site plan valid for sixty months ☐ Authorization to Construct is valid for a period equal to that of Improvement Permit – not to exceed sixty months.

Signed: Leona Johnson date 11/1/07

Improvement Permit by: Wesley Sparks RS date 10/31/07

Authorization to Construct by: Wesley (N) Sparks RS date 10/31/07
VOID

Installed by: Lentz Septic

Operation Permit by: Maria H Dobson RS date 11/6/07

Existing System Inspection by: date

HEALTH DEPT. COPY: WHITE OWNER COPY (FINAL): YELLOW OWNER COPY (INITIAL): PINK