IREDELL COUNTY HEALTH DEPARTMENT

Statesville Office (704) 878-5305 Mooresville Office (704) 660-3625 PERMIT # 203541

IMPROVEMENT PERMIT / AUTHORIZATION TO CONSTRUCT / OPERATION PERMIT / EXISTING SYSTEM

PIN # 4657-19-4075

APPLICANT: Knox Realty / Doug Knox APPLICANT ADDRESS: PO Box 40 Davidson NC 28036

SITE ADDRESS: 128 Quail Hollow Ln PHONE: (704) 996-7807 ALT. PHONE:

SITE DIRECTIONS: Hwy 150W, TR on 21N, TL on Oates Rd, TR on Quail Hollow, Lot On R


SUBDIVISION: ~~Quail Hollow~~ SECTION: LOT # LOT AREA: 0.53ac DESIGN FLOW: 360 gpd L.T.A.R.:

Septic Tank	1000 (gal)	STB	760	Date	12-16-13	☐ New System ☐ Repair ☐ Expansion System Type: I II III IV V VI	☑ Residence	No. Bedrooms	3
Pump Tank	(gal)	PT		Date		System Description: EXISTING	☐ Business	No. Persons	6
Pump Make		Model		Serial #		Repair System Description:	☐ Other	No. Employees	
# Nitrification Fields	# Lines	~~EXISTING~~		Linear Ft:		Maintenance Agreement Required: ☐ YES ☑ NO	☐ Slab	☑ Crawl Space	
Trench Width	Max. Trench Bottom Depth			Gravel Depth		☑ GRAVITY ☐ PRESSURE	☐ Basement w/plumbing	☐ Basement w/o plumbing	

Water Supply: ☑ Private ☐ Public ☐ Community

Comments / Conditions: * Septic Tank Replacement *

INITIAL SITE SKETCH

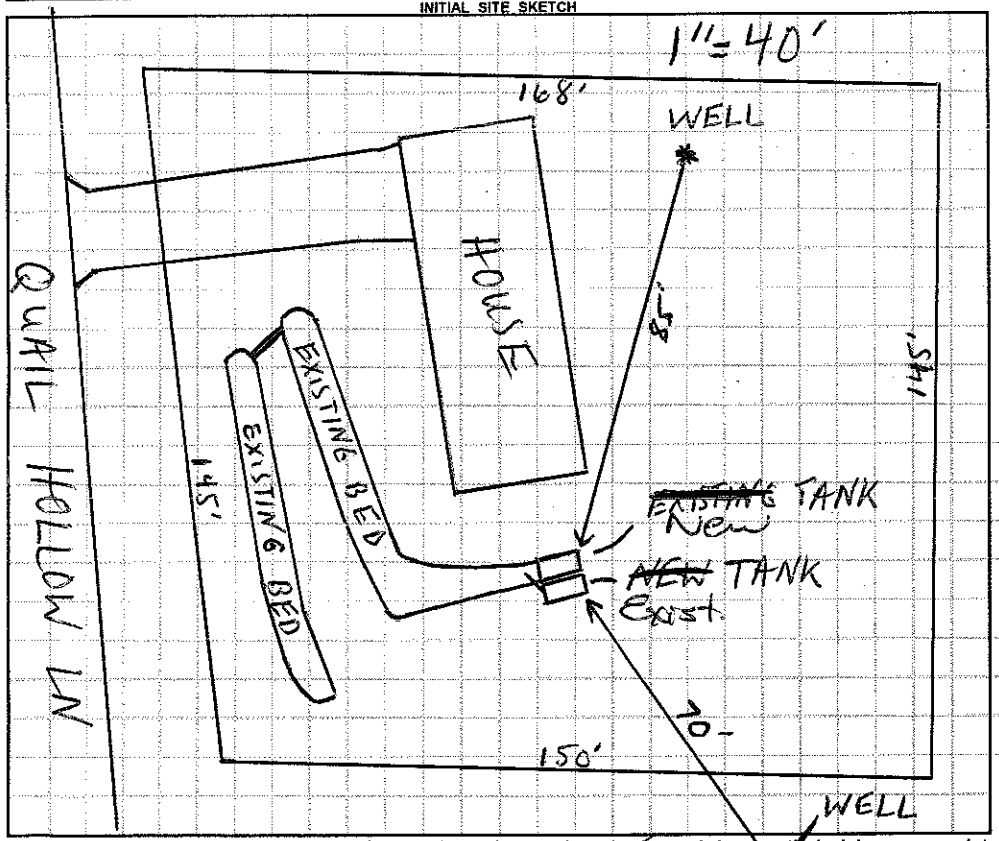

AS BUILT SKETCH

New tank Checked

Permit can be suspended or revoked if any false information is supplied toward securing the permit / any unauthorized changes are made to the site / any unauthorized changes are made in the installation of the system. **CONTACT A LOCATOR SERVICE PRIOR TO ANY EXCAVATION**

☐ **IMPROVEMENT PERMIT** *with plat valid without expiration.* ☑ **IMPROVEMENT PERMIT** *with site plan valid for 60 mos.* ☐ **AUTHORIZATION TO CONSTRUCT** *valid for period equal to IMPROVEMENT PERMIT--not to exceed 60 mo.*

Owner / Applicant Signature: Date: 6-6-14 Installed by: Jarod Wentz

IMPROVEMENT PERMIT by: Date: 6-5-14 OPERATION PERMIT by: Date: 6/9/14

AUTHORIZATION TO CONSTRUCT by: Date: 6-5-14 Existing System Inspected by: Date:

Health Dept. Copy - WHITE Applicant (Final Approval) - YELLOW Applicant (Conditional Approval) - PINK