IREDELL COUNTY HEALTH DEPARTMENT

Authorization to Construct

STATESVILLE 704-878-5305 MOORESVILLE 704-664-5281

IMPROVEMENT PERMIT / ~~CERTIFICATE OF COMPLETION~~ / OPERATION PERMIT / EXISTING SYSTEM INSPECTION

PROPERTY DESCRIPTION NO. 4475 DATE 3/25/97 TAX MAP NO. IL A 79 4657284135 Watershed: ☐ Yes ☒ No

OWNER OR CONTRACTOR Leslie Taylor PHONE: Business _____ Home 664-5477

ADDRESS 110 B Superior Dr. Mooresville, NC. 28115 145 Oates Rd.

LOCATION 21 N TL Oates Rd ~ 900' TL on gravel drive - house 450 feet from roadway

SUBDIVISION _____ BLOCK / SECTION _____ LOT _____ LOT AREA ~ 6 Ac SITE CLASS. PS DESIGN FLOW 600 L.T.A.R. .25

Septic Tank: 1500 Gallons; STB 797 Date 1500

Pump Tank: 1250 Gallons; PT 27 Date 1000

Pump Make: GOULD Model WE0511H Serial No. K9832553

Nitrification Field: No Fields 6 Square Feet 2400 Linear Feet 800 ✱

No Lines 8 Trench Width 36 Max Trench Bottom Depth 30" Gravel Depth 12"

☒ New System ☐ Repair System Type: I, II, (III), IV, V, VI

System Description: Pressure - Conventional

Repair System Description: Same

Maintenance Agreement Required: ☐ Yes ☒ No

☒ House/Mod. Home No. Bedrooms 5

☐ Mobile Home No. Bathrooms _____

☐ Business No. Employees _____

☐ Other _____

☒ Slab ☐ Crawl Space ☐ Basement w/plumbing ☐ Basement wo/plumbing


Water Supply: ☒ Individual ☐ Community ☐ Public

Comments: ✱ Exceeds 750 linear feet - must be pumped


P/L

Comments:

INITIAL SITE SKETCH

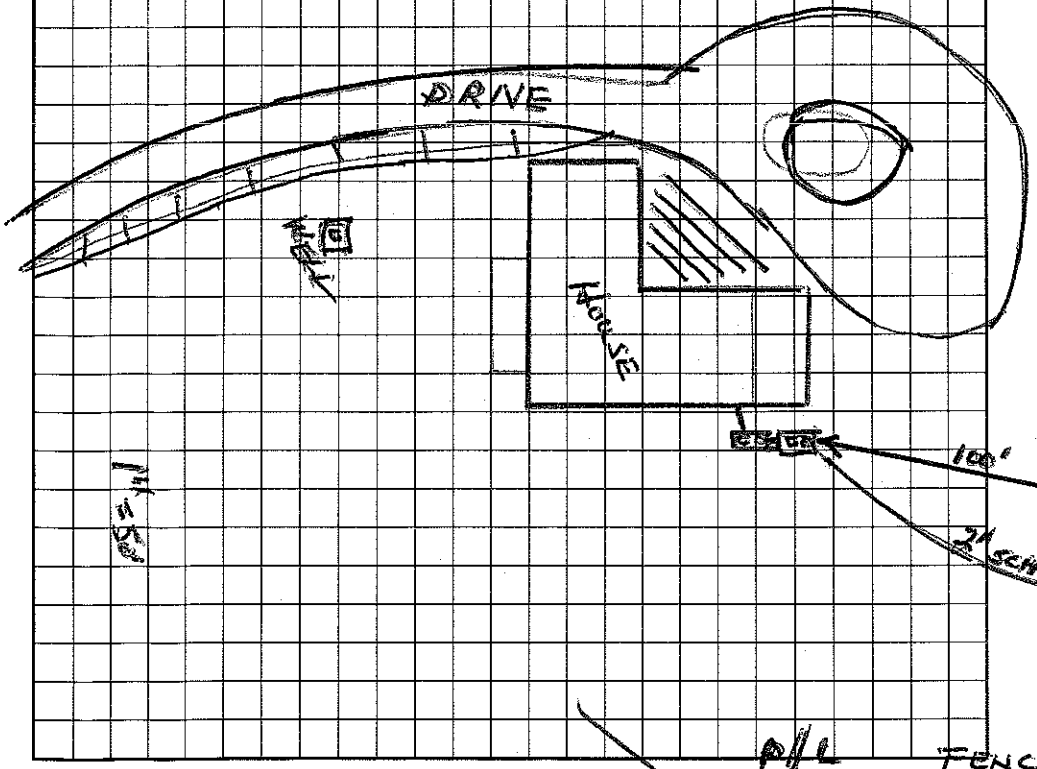

AS BUILT SKETCH

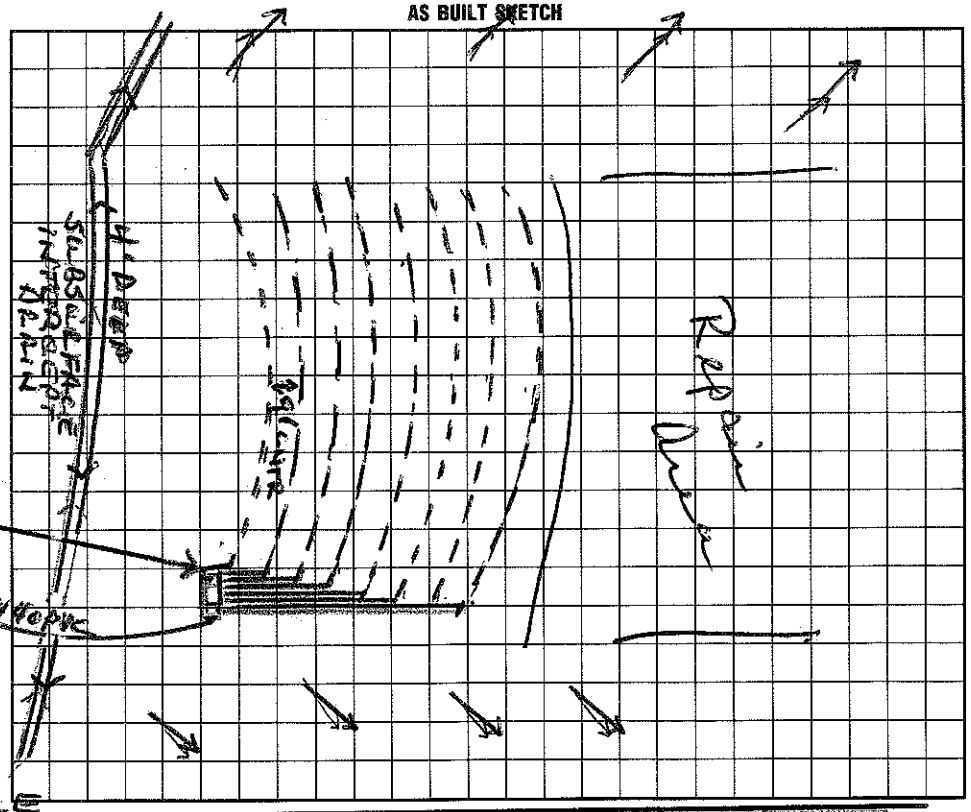

~~I understand that this permit can be suspended or revoked if any false information is supplied toward securing the permit/any unauthorized changes are made to the site/any unauthorized changes are made in the installation of the system.~~ Improvement Permit is valid for 60 months from date of issuance.

Signed: ✱ Leslie Taylor

Improvement Permit by: Wesley Sparks R.S. date 3/26/97

Authorization to Construct by: Wesley Sparks R.S. date 3/26/97

Installed by: Leslie Taylor.

Certificate of Completion by: Wesley Sparks R.S. date 9/13/99

Operation Permit by: Wesley Sparks R.S. date 7/13/99

HEALTH DEPT. COPY: WHITE INSPECTION COPY (FINAL): GREEN OWNER COPY (FINAL): YELLOW INSPECTION COPY (INITIAL): PINK OWNER COPY (INITIAL): GOLD