IREDELL COUNTY HEALTH DEPARTMENT

Statesville Phone TR 3-7271 Mooresville Phone NO 3-1271

PERMIT TO INSTALL SEPTIC TANK

Permit NO._____ Permit Date 4-25 1963

Owner Paul Stedman Address Statesville, N C

Installed By Hoke (Clyde) Address Statesville, N C


Location of Property Colony Acres Valley Stream Rd Lot #3

Tank		Capacity		Length of Lines		Fixtures	
Block	( )	800	( )	150'	( )	No. of Baths	( )
Precast	(X)	900	( )	175'	( )	Dishwasher	( )
		1000	(X)	200'	( )	Garbage Grdr.	( )
		1100	( )	225'	(X)	Auto-Washer	( )
		1200	( )	250'	( )	Other_____	
		Other_____		Other_____			

NOTIFY HEALTH DEPARTMENT AT LEAST EIGHT HOURS BEFORE TANK IS TO BE INSPECTED.

Final Inspection 4-26 1963 Approved (✓) Disapproved ( )

Remarks F.H.A. #98795 Lot #3

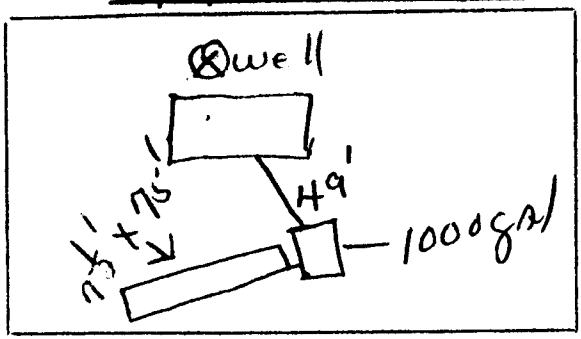

Sketch of Installation

Ray R Sergeant R-S

Sanitarian