IREDELL COUNTY HEALTH DEPARTMENT

Statesville Phone TR 3-7271 Mooresville Phone NO 3-1271

PERMIT TO INSTALL SEPTIC TANK

Permit No. _____ Permit Date 15 May 1964

Owner Stalman Bld Co. Address Statesville NC

Installed By Bill Martin Address " "

Location of Property Colony Acres Mooresville, NC


Lot 14 (Dirt mostly Tallow)

Tank		Capacity		Length of Lines		Fixtures	
Block	( )	1000	( )	225'	( )	No. of Baths	( )
Precast	(X)	1250	( )	250'	( )	Dishwasher	( )
		1500	( )	Other 320'		Garbage Grdr.	( )
		Other _____				Other _____	

NOTIFY HEALTH DEPARTMENT AT LEAST EIGHT HOURS BEFORE TANK IS TO BE INSPECTED.

Final Inspection 15 May 1964 Approved (X) Disapproved ( )

Remarks Sump well 22' from Spigot on rear of house.

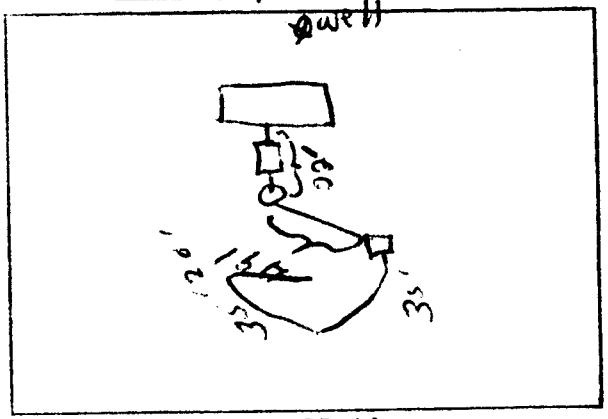

Sketch of Installation

Ivy A. Sawyer

Sanitarian