IREDELL COUNTY HEALTH DEPARTMENT

Statesville Phone TR 3-7271 Mooresville Phone NO 3-1271

PERMIT TO INSTALL SEPTIC TANK

Permit No. _____ Permit Date 15 May 1964

Owner Stedman Bld Co. Address Statesville, N.C.

Installed By Bill Martin Address " "


Location of Property Lot 7 Colony Acres

Tank		Capacity		Length of Lines		Fixtures	
Block	( )	1000	(Y)	225'	( )	No. of Baths	( )
Precast	(X)	1250	( )	250'	( )	Dishwasher	( )
		1500	( )	Other 320		Garbage Grdr.	( )
		Other				Other	

NOTIFY HEALTH DEPARTMENT AT LEAST EIGHT HOURS BEFORE TANK IS TO BE INSPECTED.

Final Inspection 15 May 1964 Approved (Y) Disapproved ( )

Remarks _____

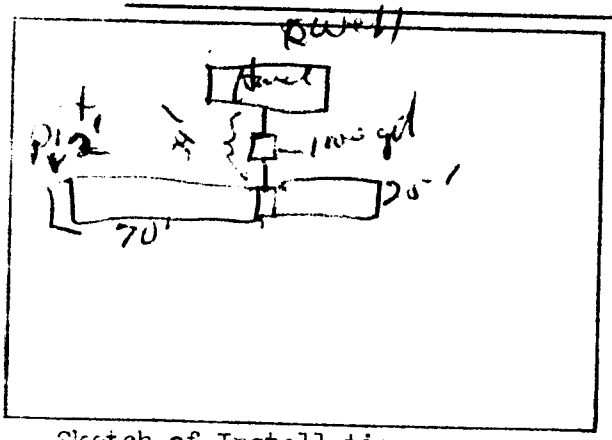

Sketch of Installation

Wm Lawson 28

Sanitarian