IREDELL COUNTY HEALTH DEPARTMENT

Statesville Phone TR 3-7271 Mooresville Phone NO 3-1271

PERMIT TO INSTALL SEPTIC TANK

Permit NO. _____ Permit Date 21 April 1967

Builder Edmisten & Brinkley Address Statesville N.C

Installed By Clyde Hoke Address Statesville, N.C.

Location of Property Colony Acres Lot # 8


F.H.A + V.A Approved

Tank		Capacity		Length of Lines		Fixtures	
Block	( )	1000	(✓)	225'	( )	No. of Baths	( )
Precast	(✓)	1250	( )	250'	( )	Dishwasher	( )
		1500	( )	Other 340'		Garbage Grdr.	( )
		Other _____				Other _____	

NOTIFY HEALTH DEPARTMENT AT LEAST EIGHT HOURS BEFORE TANK IS TO BE INSPECTED.

Final Inspection 21 April 1967 Approved (✓) Disapproved ( )

Remarks _____

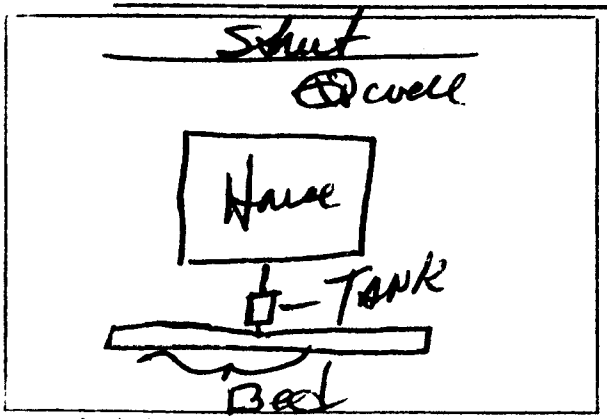

Sketch of Installation

Ray Scoggins RE

Sanitarian