IREDELL COUNTY HEALTH DEPARTMENT

Statesville Phone TR 3-7271 Mooresville Phone NO 3-1271

PERMIT TO INSTALL SEPTIC TANK

Permit NO. _____ Permit Date Dec 30 1964

Owner Paul Stedman Address Statesville NC.

Installed By Clyde Hoke Address Statesville N. C.

Location of Property Colony Acres (Mooresville).


Lot # 11. Case 111377

Tank	Capacity	Length of Lines	Fixtures
Block ( )	800 ( )	150' ( )	No. of Baths ( )
Precast (✓)	900 ( )	175' ( )	Dishwasher ( )
	1000 (✓)	200' ( )	Garbage Grdr. ( )
	1100 ( )	225' ( )	Auto-Washer ( )
	1200 ( )	250' ( )	Other _____
	Other _____	Other [redacted] 860 & Ft.	

NOTIFY HEALTH DEPARTMENT AT LEAST EIGHT HOURS BEFORE TANK IS TO BE INSPECTED.

Final Inspection Dec 30 1964 Approved (✓) Disapproved ( )

Remarks 8' x 10'

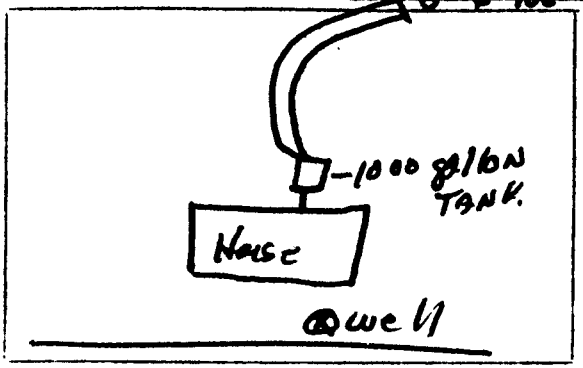

Sketch of Installation

Ina R. Scoggins RS
Sanitarian