IREDELL COUNTY HEALTH DEPARTMENT

Statesville Phone TR 3-7271 Mooresville Phone NO 3-1271

PERMIT TO INSTALL SEPTIC TANK

Permit NO. _____ Permit Date 21 April 1967

Builder ~~Owner~~ Edmiston + Brinkley Address Statesville, N.C.

Installed By Clyde Hoke Address Statesville, N.C.

Location of Property Colony Acres Lot # 9


F.H.A + V.A approved.

Tank		Capacity		Length of Lines		Fixtures	
Block	( )	1000	( )	225'	( )	No. of Baths	( )
Precast	( )	1250	( )	250'	( )	Dishwasher	( )
		1500	( )	Other 240'		Garbage Grdr.	( )
		Other				Other	

NOTIFY HEALTH DEPARTMENT AT LEAST EIGHT HOURS BEFORE TANK IS TO BE INSPECTED.

Final Inspection 21 April 1967 Approved ( ) Disapproved ( )

Remarks Shoot 860 sq ft of Drain.

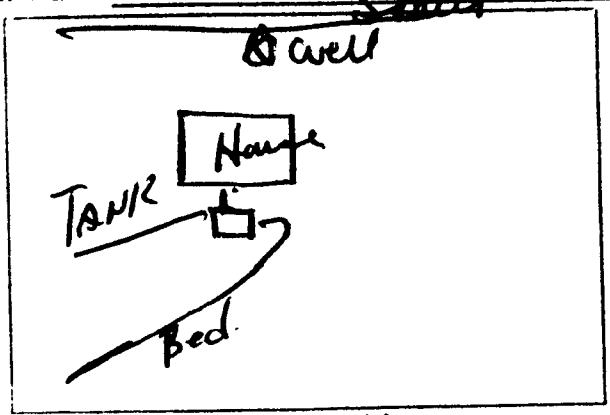

Sketch of Installation

T M Scroggs RS

Sanitarian