IREDELL COUNTY HEALTH DEPARTMENT

STATESVILLE 704-878-5305 330.00 Paid 10/15 MOORESVILLE 704-664-5281

IMPROVEMENT PERMIT / AUTHORIZATION TO CONSTRUCT / OPERATION PERMIT / EXISTING SYSTEM INSPECTION

PERMIT# 124269 PIN# 4657-37-7637 DATE 12-22-04

OWNER OR CONTRACTOR J Douglas & Jenny Turner PHONE: Business 871-4150 Home 660-6488

ADDRESS 2493 Charlotte Highway Mooresville NC 28115

LOCATION US 21 North over Hwy 150 ~ 1.5 miles on right before Oates Rd

SUBDIVISION 1500 BLOCK / SECTION LOT LOT AREA SITE CLASS PS DESIGN FLOW 900gpd L.T.A.R. .83

WP1550 Grease Trap WP1550

Septic Tank 2000 1500 Gallons; STB 2608 Date 8-26-04 ☒ New System ☐ Repair System Type: I, II, III, IV, V, VI

Pump Tank 2000 1500 Gallons; PT 2608 Date 8-18-04 System Description: Gravity - 25% Reduction

Pump Make: Model Serial No. Repair System Description: Pump - 25% Reduction

Nitrification Field: No Fields 1 Square Feet 2310 Linear Feet 770' Maintenance Agreement Required: ☐ Yes ☐ No

No Lines 7@110' Trench Width 36" Max Trench Bottom Depth 30" Gravel Depth N/A

☐ House/Mod. Home ☐ Mobile Home ☐ Business ☒ Other Day Care - ~~60~~ 55 kids


No. Bedrooms ___ No. Bathrooms ___ No. Employees 25

☐ Slab ☒ Crawl Space ☐ Basement w/plumbing ☐ Basement wo/plumbing

Water Supply: ☒ Individual ☐ Public ☐ Community


Comments/Conditions: Stay at least 10' from PL & 100' to well. Stay out of old Drainfield. Kitchen waste must go through "Grease Trap" first then to ST. Domestic waste to ST

INITIAL SITE SKETCH

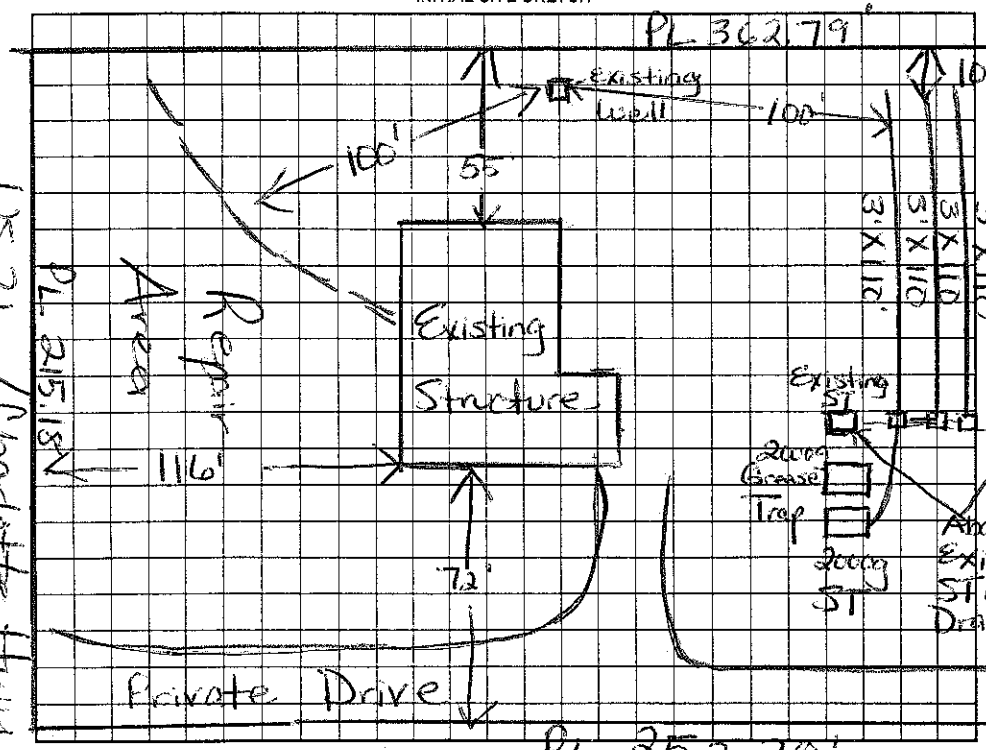

Comments/Conditions: Note: Abandon Existing ST per Inspections Dept. requirements. Keep new Drainfield out of existing Drainfield. ☒ Maximum Number of Kids = ~~60~~ 55

AS BUILT SKETCH

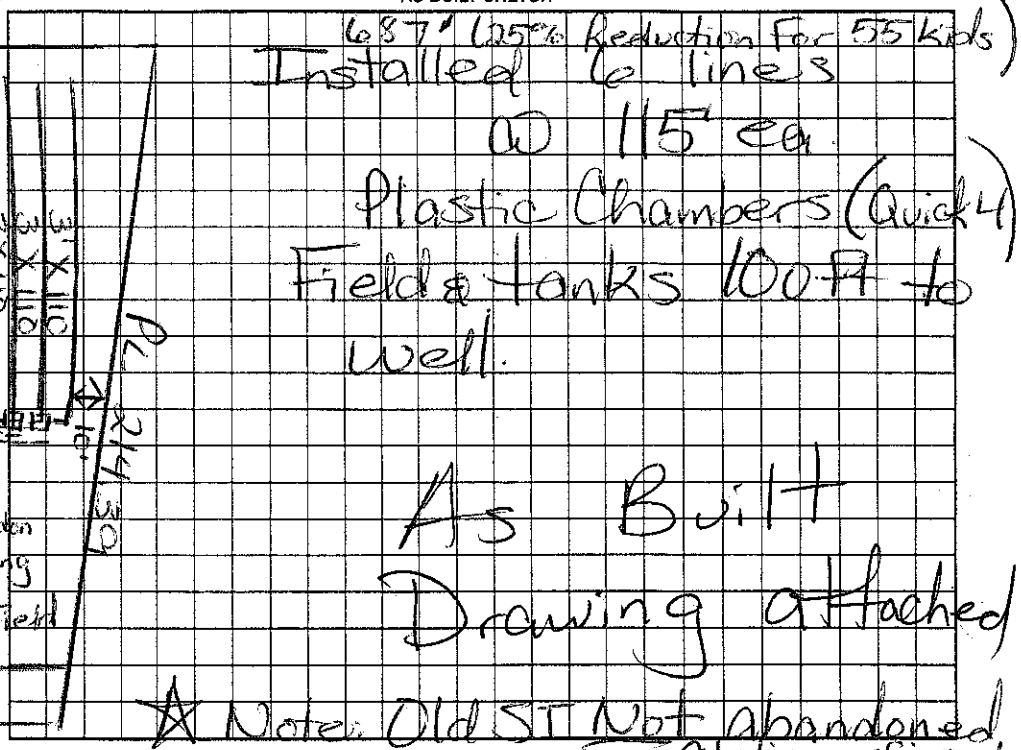

Permit can be suspended or revoked if any false information is supplied toward securing the permit/any unauthorized changes are made to the site/any unauthorized changes are made in the installation of the system. Improvement Permit with plat valid without expiration. Improvement Permit with site plan valid for sixty months. Authorization to Construct is valid for a period equal to that of Improvement Permit – not to exceed sixty months.

Signed: [signature] date 12-23-04 Installed by: ~~State~~ Treadell Backhoe

Improvement Permit by: Maina M. Dotson RS date 12/22/04 Operation Permit by: Maina M. Dotson RS date 1/27/05

Authorization to Construct by: Maina M. Dotson RS date 12/22/04 Existing System Inspection by: ___ date ___

HEALTH DEPT. COPY: WHITE OWNER COPY (FINAL): YELLOW OWNER COPY (INITIAL): PINK

As Built

IREDELL COUNTY HEALTH DEPARTMENT

STATESVILLE 704-878-5305 MOORESVILLE 704-664-5281

IMPROVEMENT PERMIT / AUTHORIZATION TO CONSTRUCT / OPERATION PERMIT / EXISTING SYSTEM INSPECTION

PERMIT# 12426 PIN# 4657376643 DATE 1/27/05

OWNER OR CONTRACTOR Douglas & Jenny Turner PHONE: Business 871-4150 Home 660 6458

ADDRESS 2493 Charlotte Hwy

LOCATION

SUBDIVISION BLOCK / SECTION LOT LOT AREA SITE CLASS. DESIGN FLOW L.T.A.R.

Septic Tank: 1550 Gallons; STB WP 268 Date 8-26-04

Pump Tank: 1550 Gallons; PT 268 Date 5-18-04

Pump Make: Model Serial No.

Nitrification Field: No Fields 1 Square Feet Linear Feet

No Lines 6@15 Trench Width 36" Max Trench Bottom Depth 30" Gravel Depth N/A

Areas Trip

☒ New System ☐ Repair System Type: I, II, III, IV, V, VI (2)

System Description Gravity - 25% Reduction

Repair System Description:

Maintenance Agreement Required: ☐ Yes ☐ No

☐ House/Mod. Home No. Bedrooms

☐ Mobile Home No. Bathrooms

☐ Business No. Employees

☒ Other Daycare 55 kids


☐ Slab ☐ Crawl Space ☐ Basement w/plumbing ☐ Basement wo/plumbing

Water Supply: ☒ Individual ☐ Public ☐ Community


Comments:/Conditions:

Comments:/Conditions:

INITIAL SITE SKETCH

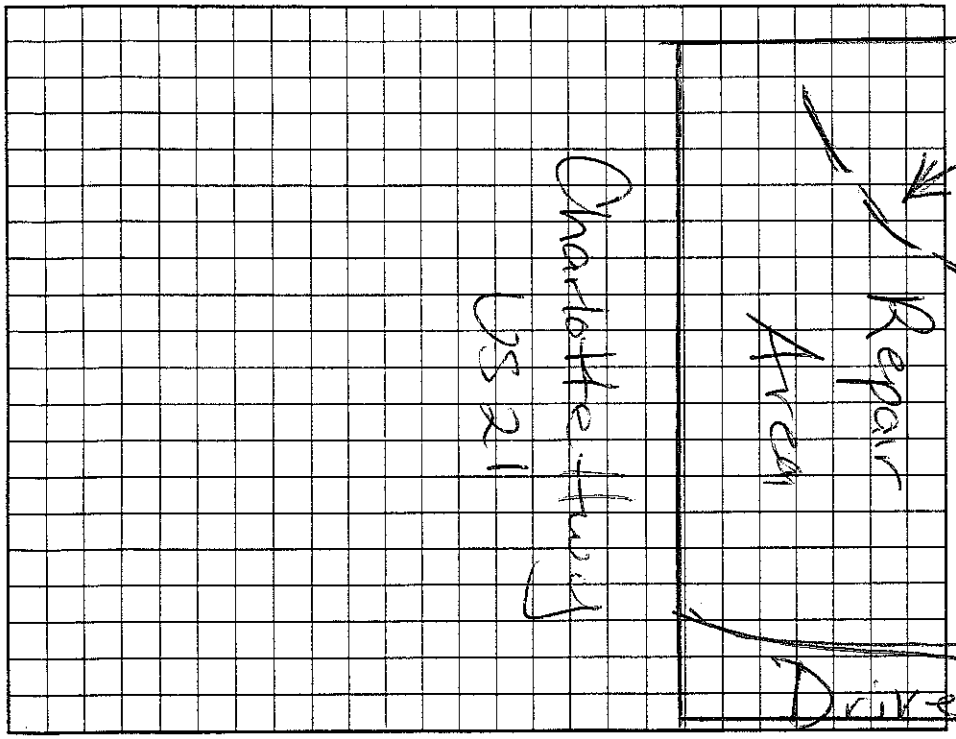

AS BUILT SKETCH

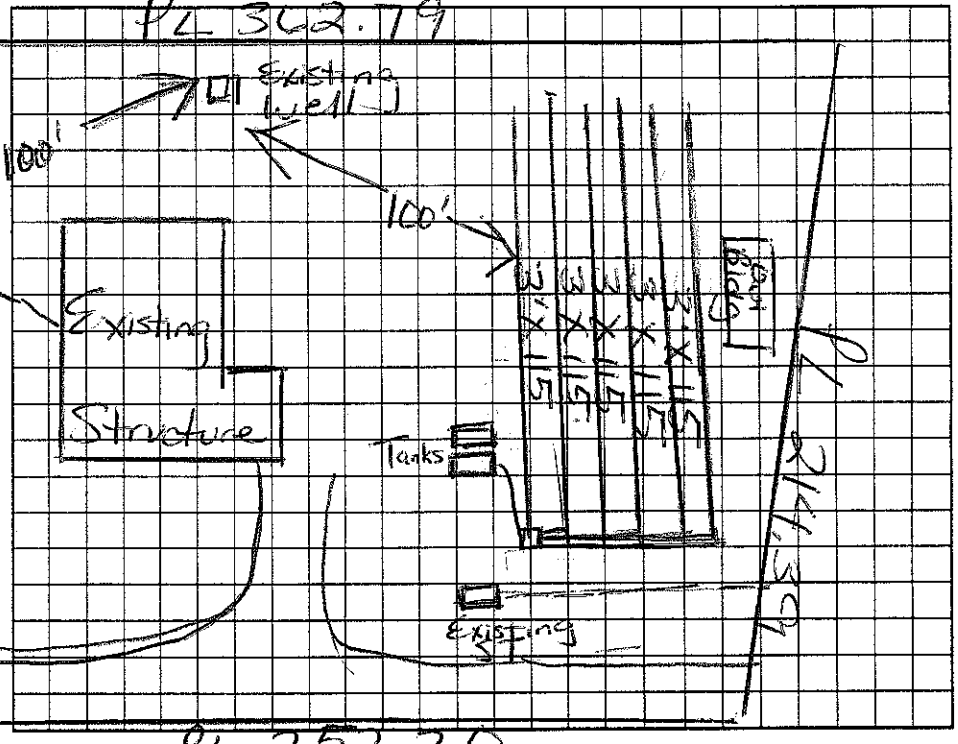

Permit can be suspended or revoked if any false information is supplied toward securing the permit/any unauthorized changes are made to the site/any unauthorized changes are made in the installation of the system. Improvement Permit with plat valid without expiration. Improvement Permit with site plan valid for sixty months. Authorization to Construct is valid for a period equal to that of Improvement Permit – not to exceed sixty months.

Signed: date

Improvement Permit by: date

Authorization to Construct by: date

Installed by: Tredell Backhoe

Operation Permit by: Maria H. Dotson date 1/27/05

Existing System Inspection by: date

HEALTH DEPT. COPY: WHITE OWNER COPY (FINAL): YELLOW OWNER COPY (INITIAL): PINK