IREDELL COUNTY HEALTH DEPARTMENT

STATESVILLE 704-878-5305 MOORESVILLE 704-664-5281

IMPROVEMENT PERMIT / AUTHORIZATION TO CONSTRUCT / OPERATION PERMIT / EXISTING SYSTEM INSPECTION

PERMIT# 13669B PIN# 4657379622 DATE 7-24-06

OWNER OR APPLICANT J. Douglas Turner PHONE: Business 658-1142 Home 660-6488

ADDRESS 186 Brawley School Rd Mooresville, NC 28117

2493 LOCATION US 21 (Charlotte Hwy) North approx 1.5 miles past Hwy 150 behind Ms. Jenny's Rocking Horse Ranch

SUBDIVISION _____ BLOCK / SECTION _____ LOT _____ LOT AREA 1.07 Acre SITE CLASS. PS DESIGN FLOW 370gpd L.T.A.R. —

Exist 1000g

Septic Tank: Exist Gallons: STB _____ Date _____

Pump Tank: _____ Gallons: PT _____ Date _____

Pump Make: _____ Model _____ Serial No. _____

Nitrification Field: No Fields ___ Square Feet ___ Linear Feet _____

No Lines 4 to 5 Trench Width Existing Max Trench Bottom Depth _____ Gravel Depth 12" ☒ Gravity ☐ Pressure

☐ New System ☐ Repair ☐ Expansion System Type: I II III IV V VI

System Description: Exist Gray Convential

Repair System Description: Pump-Modified Conv.

Maintenance Agreement Required: ☐ Yes ☒ No

☐ House/Mod. Home No. Bedrooms ___

☐ Mobile Home No. Persons ___

☒ Business No. Employees 4

☒ Other Daycare - 18 kids


Water Supply: ☐ Individual ☒ Public ☒ Community

☐ Slab ☒ Crawl Space ☐ Basement w/plumbing ☐ Basement wo/plumbing

Comments:/Conditions: Existing Septic System appears to be functioning Jokay at time of inspection.

Comments:/Conditions: Original Septic System sized for 3 Bedroom House, okay to used for Daycare as long as Flow does not exceed 370 gpd. (18 Kids @ 15gpd + 4 employees @ 25 gpd)

INITIAL SITE SKETCH

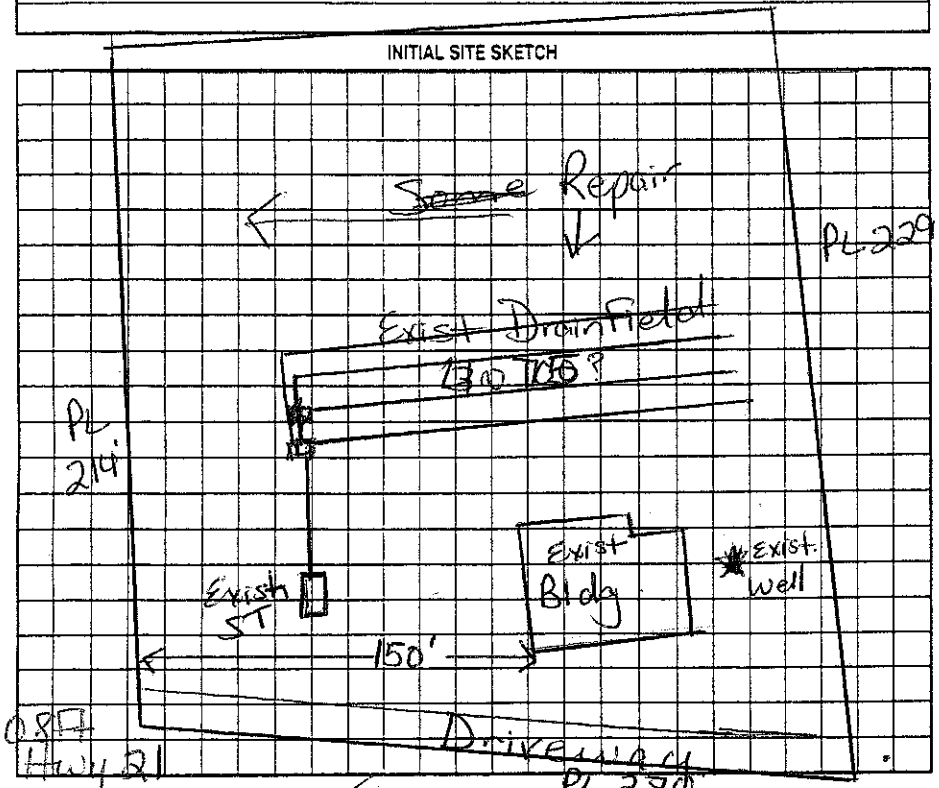

AS BUILT SKETCH

Note: Existing well shall not be used for potable (drinking water). Daycare will be hooked up to Municipal Water Supply.

Permit can be suspended or revoked if any false information is supplied toward securing the permit/any unauthorized changes are made to the site/any unauthorized changes are made in the installation of the system. Improvement Permit with plat valid without expiration ☐ Improvement Permit with site plan valid for sixty months ☐ Authorization to Construct is valid for a period equal to that of Improvement Permit – not to exceed sixty months.

Signed: _____ date 7/24/06

Improvement Permit by: Maria H. Dotson RS date 7/24/06

Authorization to Construct by: _____ date _____

Installed by: _____

Operation Permit by: _____ date _____

Existing System Inspection by: Maria H. Dotson RS date 7/24/06

HEALTH DEPT. COPY: WHITE OWNER COPY (FINAL): YELLOW OWNER COPY (INITIAL): PINK