IREDELL COUNTY HEALTH DEPARTMENT

STATESVILLE 704-878-5305 MOORESVILLE 704-664-5281

IMPROVEMENT PERMIT / AUTHORIZATION TO CONSTRUCT / OPERATION PERMIT / EXISTING SYSTEM INSPECTION

PERMIT# 1312 PIN# 4657 38 4664 DATE 5/14/01

OWNER OR CONTRACTOR Jeff Munksgard PHONE: Business Home 704-782-7785

ADDRESS 104 Summerchase Ln. Mooresville NC 28115

LOCATION 21N TR Summerchase Ln 1st house on (R)

SUBDIVISION SUMMERCHASE BLOCK / SECTION LOT 11A LOT AREA ~1.5Ac SITE CLASS. DESIGN FLOW L.T.A.R.

Septic Tank: EXISTING Gallons; STB Date

Pump Tank: Gallons; PT Date

Pump Make: Model Serial No.

Nitrification Field: No Fields Square Feet Linear Feet 300

No Lines Trench Width EXISTING Max. Trench Bottom Depth Gravel Depth

☐ New System ☐ Repair System Type: I, (II) III, IV, V, VI

System Description: EXISTING GRAVITY

Repair System Description:

Maintenance Agreement Required: ☐ Yes ☐ No

☒ House/Mod. Home No. Bedrooms 3

☐ Mobile Home No. Bathrooms 3

☐ Business No. Employees

☐ Other

☐ Slab ☒ Crawl Space ☐ Basement w/plumbing ☐ Basement wo/plumbing


Water Supply: ☒ Individual ☐ Public ☐ Community

Comments:/Conditions:

Comments:/Conditions:

INITIAL SITE SKETCH

AS BUILT SKETCH

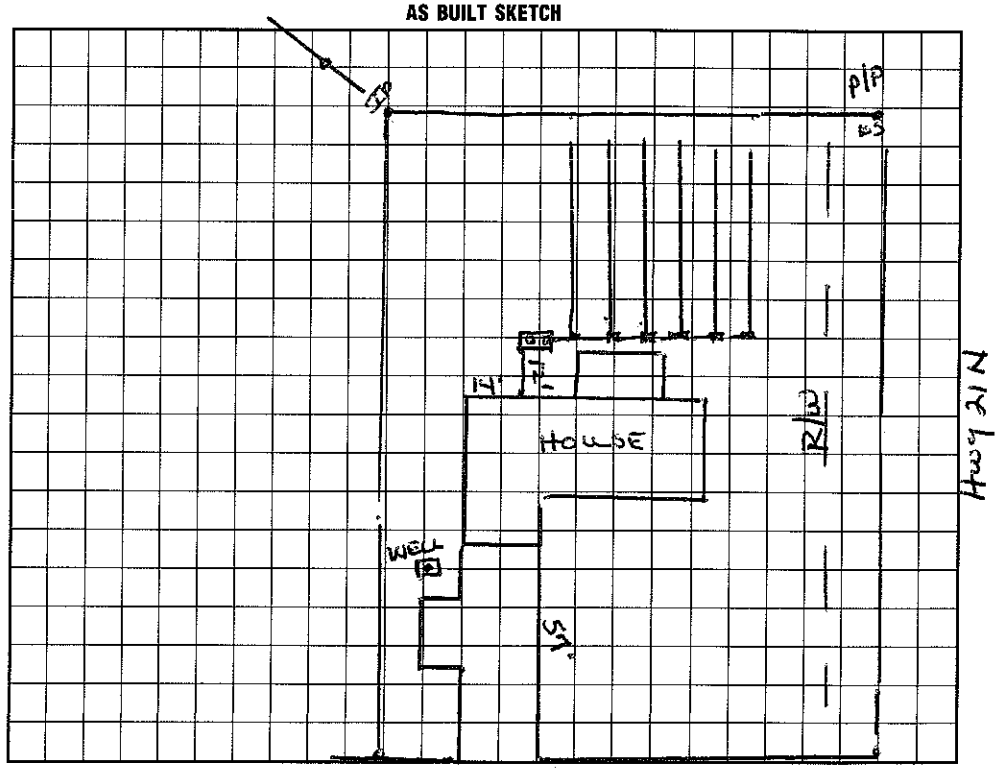

I understand that this permit can be suspended or revoked if any false information is supplied toward securing the permit/any unauthorized changes are made to the site/any unauthorized changes are made in the installation of the system. Improvement Permit with plat valid without expiration. Improvement Permit with site plan valid for sixty months. Authorization to Construct is valid for a period equal to that of Improvement Permit – not to exceed sixty months.

Signed: date

Improvement Permit by: date

Authorization to Construct by: date

Installed by: ?

Operation Permit by: date

Existing System Inspection by: Wesley Sparks RS date 5/14/01

HEALTH DEPT. COPY: WHITE INSPECTION COPY (FINAL): GREEN OWNER COPY (FINAL): YELLOW INSPECTION COPY (INITIAL): PINK OWNER COPY (INITIAL): GOLD