IREDELL COUNTY HEALTH DEPARTMENT

Statesville Office (704) 878-5305 | Mooresville Office (704) 660-3625 | PERMIT # 215301

AP/RA

IMPROVEMENT PERMIT / AUTHORIZATION TO CONSTRUCT / OPERATION PERMIT / EXISTING SYSTEM

PIN # 4657-38-4664

APPLICANT: Edgar Miller | APPLICANT ADDRESS: 104 Summerchase Lane Mooresville, NC

PHONE: 704-787-0202 | ALT. PHONE:

SITE ADDRESS: 104 Summerchase Lane

SITE DIRECTIONS: Highway 21 North from Rt 150, 0.7 miles north Right on Summerchase Lane → 1st house on Right.

SUBDIVISION: Summerchase | SECTION: 2 | LOT # 11 | LOT AREA: 0.78 acres | DESIGN FLOW: 360 gal/day | L.T.A.R.: Existing

Septic Tank 1000 Existing (gal) | STB Existing | Date —
Pump Tank — (gal) | PT — | Date —
Pump Make — | Model — | Serial # —
Nitrification Fields 1 | # Lines 6 | Linear Ft: 300
Trench Width Existing | Max. Trench Bottom Depth Existing | Gravel Depth Existing


☐ New System ☐ Repair ☐ Expansion | System Type: I (II) III IV V VI
System Description: Existing System - Gravity
Repair System Description:
Maintenance Agreement Required: ☐ YES ☒ NO
☒ GRAVITY ☐ PRESSURE

☒ Residence | No. Bedrooms 3
☐ Business | No. Persons 6
☐ Other | No. Employees
☐ Slab ☐ Crawl Space
☐ Basement w/plumbing ☐ Basement w/o plumbing

Water Supply: ☒ Private ☐ Public ☐ Community

Comments / Conditions: It is recommended that the septic tank be pumped every 3-5 years and that any house downspouts currently discharging towards the sewage disposal system be re-routed away from the septic system

INITIAL SITE SKETCH

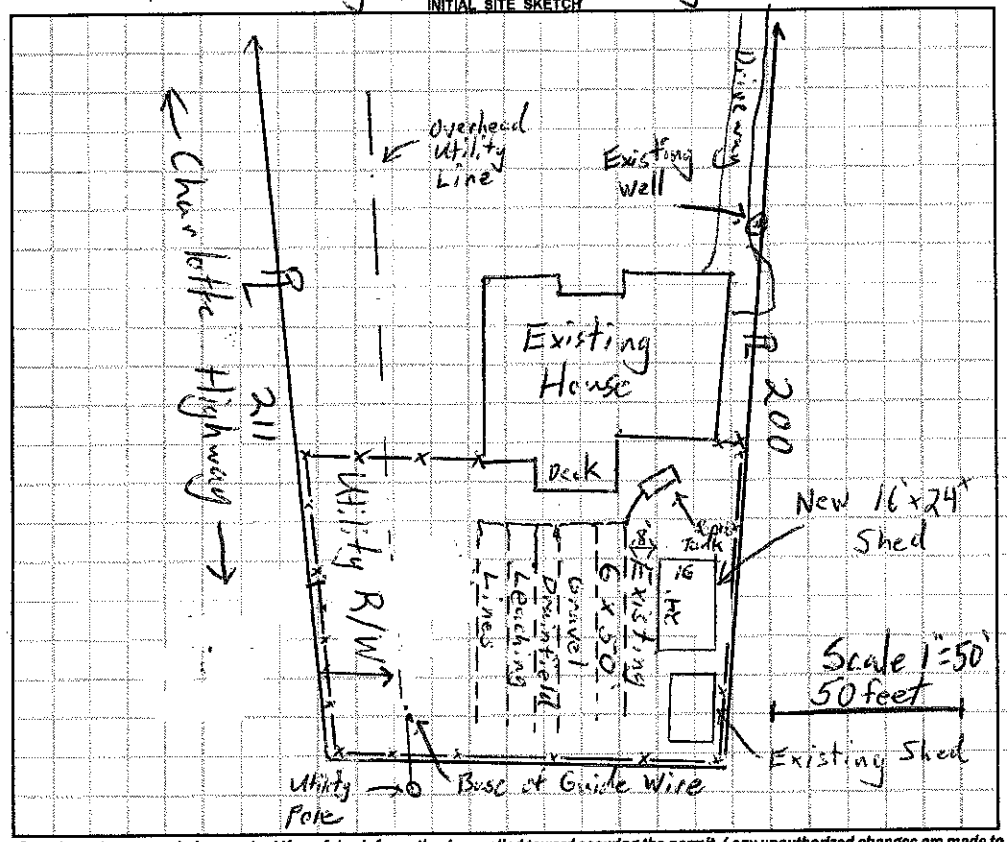

AS BUILT SKETCH

Permit can be suspended or revoked if any false information is supplied toward securing the permit / any unauthorized changes are made to the site / any unauthorized changes are made in the installation of the system. **CONTACT A LOCATOR SERVICE PRIOR TO ANY EXCAVATION**

☐ **IMPROVEMENT PERMIT** *with plat valid without expiration.* ☐ **IMPROVEMENT PERMIT** *with site plan valid for 60 mos.* ☐ **AUTHORIZATION TO CONSTRUCT** *valid for period equal to IMPROVEMENT PERMIT--not to exceed 60 mo.*

Owner / Applicant Signature: Edgar Miller | Date: 1/29/16 | Installed by:

IMPROVEMENT PERMIT by: | Date: | OPERATION PERMIT by: | Date:

AUTHORIZATION TO CONSTRUCT by: | Date: | Existing System Inspected by: Tom Shuck | Date: 1-21-16

Health Dept. Copy - WHITE Applicant (Final Approval) - YELLOW Applicant (Conditional Approval) - PINK

House
Deck
Backyard
Guide Wire
Utility Pole
66' to Guide Wire
≈17'
39'
23'
16'
7'
18'
12'
5'
63'
95'
47'
34'
32'
21'