IREDELL COUNTY HEALTH DEPARTMENT

STATESVILLE 704-878-5305 MOORESVILLE 704-664-5281

IMPROVEMENT PERMIT / CERTIFICATE OF COMPLETION / OPERATION PERMIT / EXISTING SYSTEM INSPECTION

PROPERTY DESCRIPTION NO. 7263 DATE 12/15/99 TAX MAP NO. 4657 38 5673 Watershed: [X] Yes [ ] No

OWNER OR CONTRACTOR JD PARKER III PHONE: Business Home 664-1812

ADDRESS 1110 SUMMERCHASE LANE MOORESVILLE, NC 28115

LOCATION 2 IN FROM 150 TR SUMMERCHASE LANE, 1110 ON (R)

SUBDIVISION SUMMERCHASE BLOCK / SECTION LOT 10 LOT AREA .55AC SITE CLASS. PS DESIGN FLOW 480 L.T.A.R. .3

Septic Tank: EXISTING Gallons; STB Date

Pump Tank: Gallons; PT Date

Pump Make: Model Serial No.

Nitrification Field: No Fields 1 Square Feet 300 Linear Feet 100

No Lines 1 Trench Width 36" Max Trench Bottom Depth 36" Gravel Depth SAND

[ ] New System [ ] Repair System Type: I, II, [III], IV, V, VI

System Description: ADD TO EXISTING SYSTEM

Repair System Description:

Maintenance Agreement Required: [ ] Yes [X] No

[X] House/Mod. Home No. Bedrooms 4

[ ] Mobile Home No. Bathrooms 3

[ ] Business No. Employees

[ ] Other

[ ] Slab [X] Crawl Space [ ] Basement w/plumbing [ ] Basement wo/plumbing


Water Supply: [X] Individual [ ] Community [ ] Public

Comments: ADDING FAMILY ROOM - OFFICE - MASTER BEDROOM

ADD 100' X 3' CH. PLASTIC DRAINLINE

Comments: Old system under distress - Water Conservation should be practiced.

INITIAL SITE SKETCH

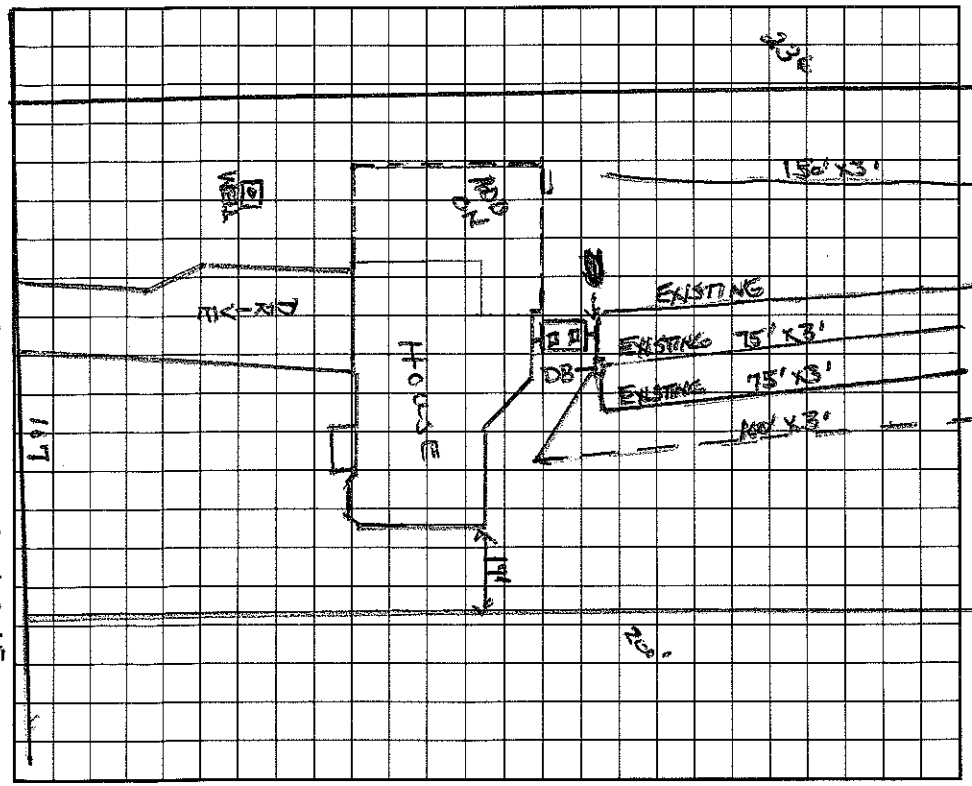

AS BUILT SKETCH

I understand that this permit can be suspended or revoked if any false information is supplied toward securing the permit/any unauthorized changes are made to the site/any unauthorized changes are made in the installation of the system. Improvement Permit is valid for 60 months from date of issuance.

Signed: [signature]

Improvement Permit by: Wesley Sparks RS. date 12/15/99

~~Authorized~~ Existing System Inspection by: Wesley Sparks RS. date 12/15/99

Installed by: Larry Beam

Certificate of Completion by: Wesley Sparks RS. date 3/16/00

Operation Permit by: date

HEALTH DEPT. COPY: WHITE INSPECTION COPY (FINAL): GREEN OWNER COPY (FINAL): YELLOW INSPECTION COPY (INITIAL): PINK OWNER COPY (INITIAL): GOLD