IREDELL COUNTY HEALTH DEPARTMENT

STATESVILLE 704-878-5305 MOORESVILLE 704-664-5281

IMPROVEMENT PERMIT / AUTHORIZATION TO CONSTRUCT / OPERATION PERMIT / EXISTING SYSTEM INSPECTION

PERMIT# 4924 PIN# 4657386839 DATE 4/3/98

OWNER OR CONTRACTOR Jerry Waggoner PHONE: Business 278-9083 Home

ADDRESS 630 Plaid Dr Mt. Ulla, NC 28125

LOCATION US 21 N. past Hwy 150 ~ 2 miles on Right TR into Summerhaase 3rd lot on left

SUBDIVISION Summerhaase BLOCK / SECTION — LOT 3 LOT AREA ~1.5Acre SITE CLASS. PS DESIGN FLOW 360gpd L.T.A.R. .3

Septic Tank: 1000 Gallons; STB Date 8/16/18
Pump Tank: Gallons; PT Date
Pump Make: Model Serial No.
Nitrification Field: No Fields 1 Square Feet 900' Linear Feet 300'
No Lines 4 at 75' Trench Width 36" Max Trench Bottom Depth 36"

[X] New System [ ] Repair System Type: I, II, [III], IV, V, VI
System Description: Gravity - Plastic Chamber or Similar
Repair System Description: Same
Maintenance Agreement Required: [ ] Yes [X] No

[X] House/Mod. Home No. Bedrooms 3
[ ] Mobile Home No. Bathrooms 3
[ ] Business No. Employees
[ ] Other


Gravel Depth N/A [ ] Slab [X] Crawl Space [ ] Basement w/plumbing [ ] Basement wo/plumbing

Water Supply: [X] Individual [ ] Public [ ] Community

Comments:/Conditions: 25% Reduction in Drainfield Area
Keep Septic System 5' from House & 10' from PL & 100' to well.

Comments:/Conditions:

INITIAL SITE SKETCH

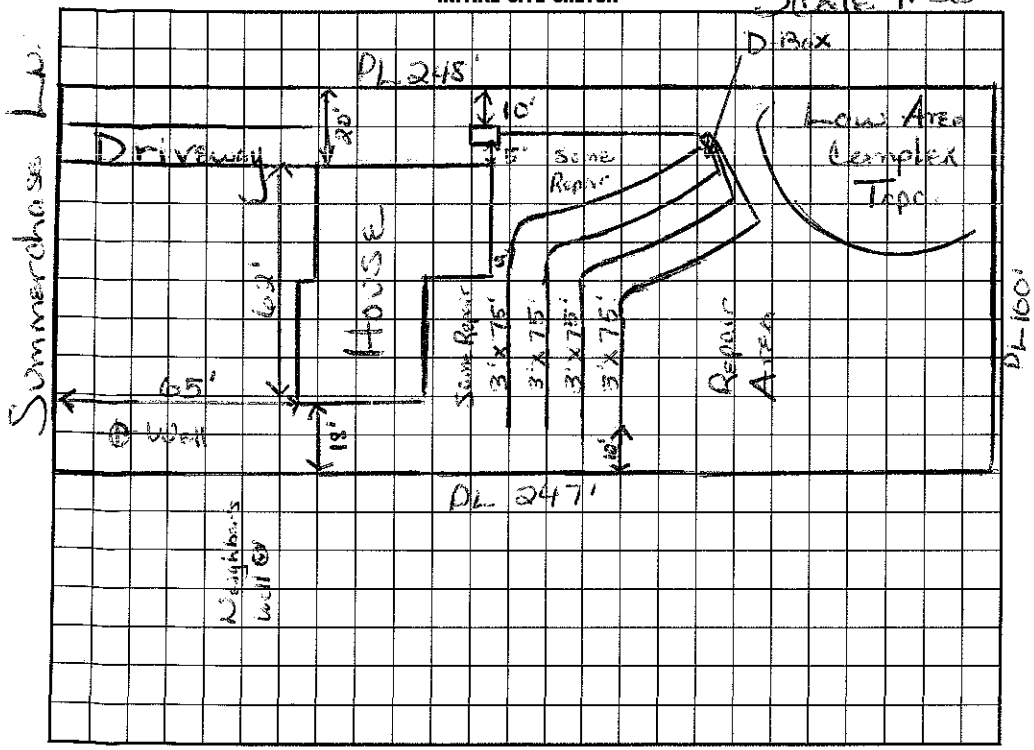

AS BUILT SKETCH

I understand that this permit can be suspended or revoked if any false information is supplied toward securing the permit/any unauthorized changes are made to the site/any unauthorized changes are made in the installation of the system. Improvement Permit with plat valid without expiration. Improvement Permit with site plan valid for sixty months. Authorization to Construct is valid for a period equal to that of Improvement Permit – not to exceed sixty months.

Signed: Kelly Dodson date 4-7-98

Improvement Permit by: Maina Dotson date 4/3/98

Authorization to Construct by: Maina H. Dotson date 4/3/98

Installed by: Orbison

Operation Permit by: Wesley Sparks R.S. date 10/20/98

Existing System Inspection by: date

HEALTH DEPT. COPY: WHITE INSPECTION COPY (FINAL): GREEN OWNER COPY (FINAL): YELLOW INSPECTION COPY (INITIAL): PINK OWNER COPY (INITIAL): GOLD