IREDELL COUNTY HEALTH DEPARTMENT

Authorization to Construct 4657395701

STATESVILLE 704-878-5305 MOORESVILLE 704-664-5281

IMPROVEMENT PERMIT / ~~CERTIFICATE OF COMPLETION~~ / OPERATION PERMIT / EXISTING SYSTEM INSPECTION

PROPERTY DESCRIPTION NO. 23749 DATE 5/31/96 TAX MAP NO. 1M-A-78 pt of Watershed: ☑ Yes ☐ No

OWNER OR CONTRACTOR Wanda & Larry Stutts PHONE: Business _____ Home _____

ADDRESS 2395 Charlotte Hwy Mooresville

LOCATION (2395 Charlotte Hwy) / 21 N - to #2395

SUBDIVISION _____ BLOCK / SECTION _____ LOT _____ LOT AREA ~20 ac. SITE CLASS. PS DESIGN FLOW 360gpd J.A.R. .25 ~~.4~~

Septic Tank: 1000 Gallons; STB 794 Date 1-28-93

Pump Tank: _____ Gallons; PT _____ Date _____

Pump Make: _____ Model _____ Serial No. _____

Nitrification Field: No Fields 1 Square Feet 1440 Linear Feet 480

No Lines 4 Trench Width 36" Max Trench Bottom Depth 36" Gravel Depth 12"

☑ New System ☐ Repair System Type: I II III IV V VI

System Description: Gravity Conventional

Repair System Description: Pump / Gravity Conv.

Maintenance Agreement Required: ☐ Yes ☑ No

☐ House/Mod. Home No. Bedrooms 3

☑ Mobile Home No. Bathrooms 2

☐ Business No. Employees _____

☐ Other _____


☐ Slab ☑ Crawl Space ☐ Basement w/plumbing ☐ Basement wo/plumbing

Water Supply: ☑ Individual ☐ Community ☐ Public

Comments:

Comments:

INITIAL SITE SKETCH Not to Scale

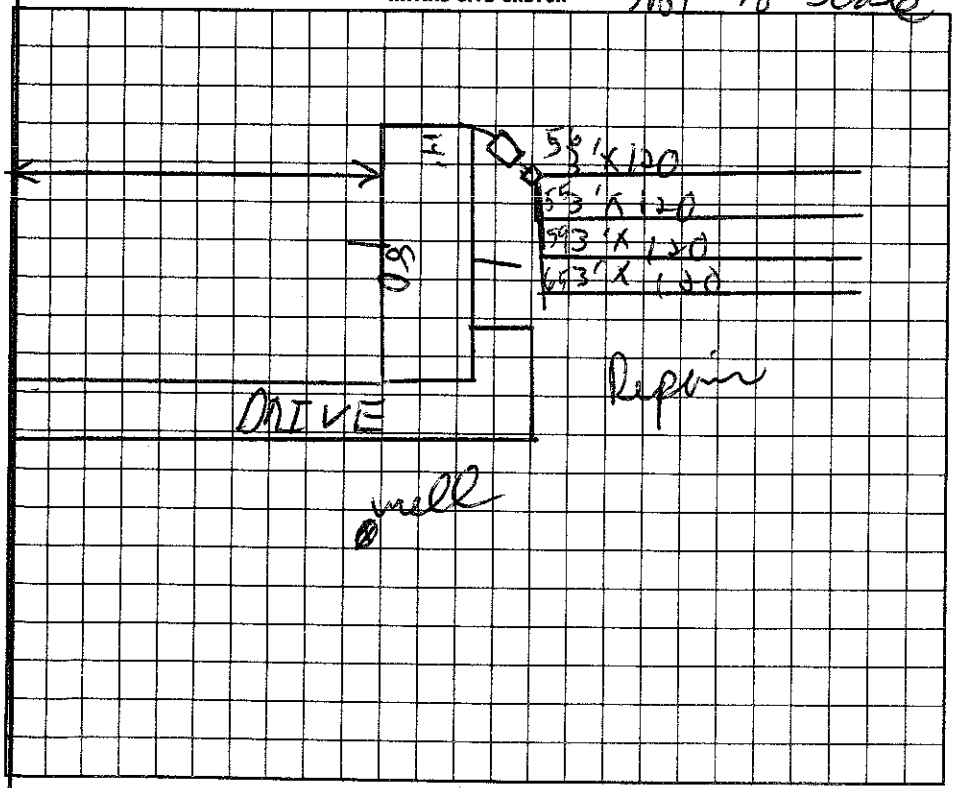

AS BUILT SKETCH

Same as initial site sketch

I understand that this permit can be suspended or revoked if any false information is supplied toward securing the permit/any unauthorized changes are made to the site/any unauthorized changes are made in the installation of the system.

Signed: Larry R. Stutts

Installed by: A-1 Backhoe

Improvement Permit by: C. Ruby Anderson EHSI date 5/31/96

Authorization to Construct

Existing System Inspection by: C. Ruby Anderson EHSI date 6/3/96

Certificate of Completion by: _____ date _____

Operation Permit by: C. Ruby Anderson EHSI date 6/21/96

HEALTH DEPT. COPY: WHITE INSPECTION COPY (FINAL): GREEN OWNER COPY (FINAL): YELLOW INSPECTION COPY (INITIAL): PINK OWNER COPY (INITIAL): GOLD

Authorization to Construct is valid for 60 months from issue date