IREDELL COUNTY HEALTH DEPARTMENT

STATESVILLE 704-878-5305 MOORESVILLE 704-664-5281

IMPROVEMENT PERMIT / AUTHORIZATION TO CONSTRUCT / OPERATION PERMIT / EXISTING SYSTEM INSPECTION

PERMIT# 103 429 PIN# ~~4657-40-4927~~ 4657 39 5818 DATE 11/15/01

OWNER OR CONTRACTOR Tim Stutts PHONE: Business Home 704-902-1988

ADDRESS 2387 Charlotte Hwy Mooresville NC 28117

LOCATION Hwy 21 N, on Rt past Oates Rd.

SUBDIVISION BLOCK / SECTION LOT LOT AREA 2 20 AC. SITE CLASS. PS DESIGN FLOW 360 L.T.A.R. .25

Septic Tank: ~~Existing~~ Gallons; STB Date

Pump Tank: Gallons; PT Date

Pump Make: Model Serial No.

Nitrification Field: No Fields Square Feet 1440 Linear Feet 480

No Lines 4@120 Trench Width Exist ~~Max Trench~~ Bottom Depth Gravel Depth

☒ New System ☐ Repair System Type: I, II, III, IV, V, VI

System Description: Conventional

Repair System Description: Conventional

Maintenance Agreement Required: ☐ Yes ☒ No

☒ House/Mod. Home ☐ Mobile Home ☐ Business ☐ Other

No. Bedrooms 3 No. Bathrooms 2.5 No. Employees


☐ Slab ☒ Crawl Space ☐ Basement w/plumbing ☐ Basement wo/plumbing

Water Supply: ☒ Individual ☐ Public ☐ Community

Comments:/Conditions:

Comments:/Conditions:

INITIAL SITE SKETCH

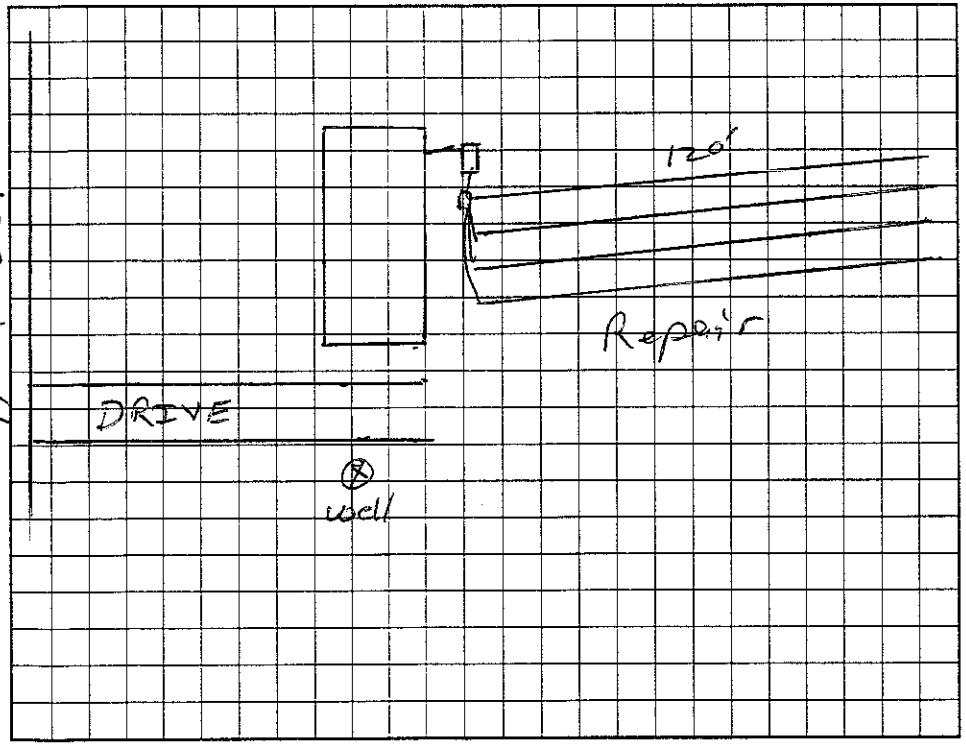

AS BUILT SKETCH

Permit can be suspended or revoked if any false information is supplied toward securing the permit/any unauthorized changes are made to the site/any unauthorized changes are made in the installation of the system. Improvement Permit with plat valid without expiration. Improvement Permit with site plan valid for sixty months. Authorization to Construct is valid for a period equal to that of Improvement Permit – not to exceed sixty months.

Signed: Boyd E Vold date 11-16-01

Improvement Permit by: date

Authorization to Construct by: date

Installed by:

Operation Permit by: date

Existing System Inspection by: RS date 11/15/01

HEALTH DEPT. COPY: WHITE OWNER COPY (FINAL): YELLOW OWNER COPY (INITIAL): PINK