IREDELL [illegible]NTY HEALTH DEPARTMENT

STATESVILLE 704-878-5305 MOORESVILLE 704-664-5281

IMPROVEM[illegible]PERMIT / AUTHORIZATION TO CONSTRUCT / OPERATION PERMIT / EXISTING SYSTEM INSPECTIO[illegible]

$150 113

PERMIT# Mooresville 21229 PIN# 4657-47-5976 DATE 9/3/02

OWNER OR CONTRACTOR Gerald Huffman PHONE: Business Home 704-663-4926

ADDRESS 1061 Emerson Dr. Mooresville NC 28115

LOCATION 2 N, TR Brantley Acres, T R Parrish on Rt.

SUBDIVISION Brantley Acres BLOCK / SECTION LOT 6 LOT AREA 1.003 AC SITE CLASS. PS DESIGN FLOW 360 L.T.A.R. 0.3

Septic Tank: 1000 Gallons; STB 825 Date 7-21-02
Pump Tank: Gallons; PT Date
Pump Make: Model Serial No.
Nitrification Field: No Fields 1 Square Feet 900 Linear Feet 300
No Lines 3 Trench Width 36" Max Trench Bottom Depth 24" Gravel Depth —

☒ New System ☐ Repair System Type: I, II, III, IV, V, VI
System Description: Gravity 25% Reduction
Repair System Description: Pump 25% Reduction
Maintenance Agreement Required: ☐ Yes ☒ No

☒ House/Mod. Home ☐ Mobile Home ☐ Business ☐ Other
No. Bedrooms 3 No. Bathrooms 2.5 No. Employees
☐ Slab ☒ Crawl Space ☐ Basement w/plumbing ☐ Basement wo/plumbing


Water Supply: ☒ Individual ☐ Public ☐ Community

Comments:/Conditions:

Comments:/Conditions: Filter installed – Polylok

1" = 60'

INITIAL SITE SKETCH

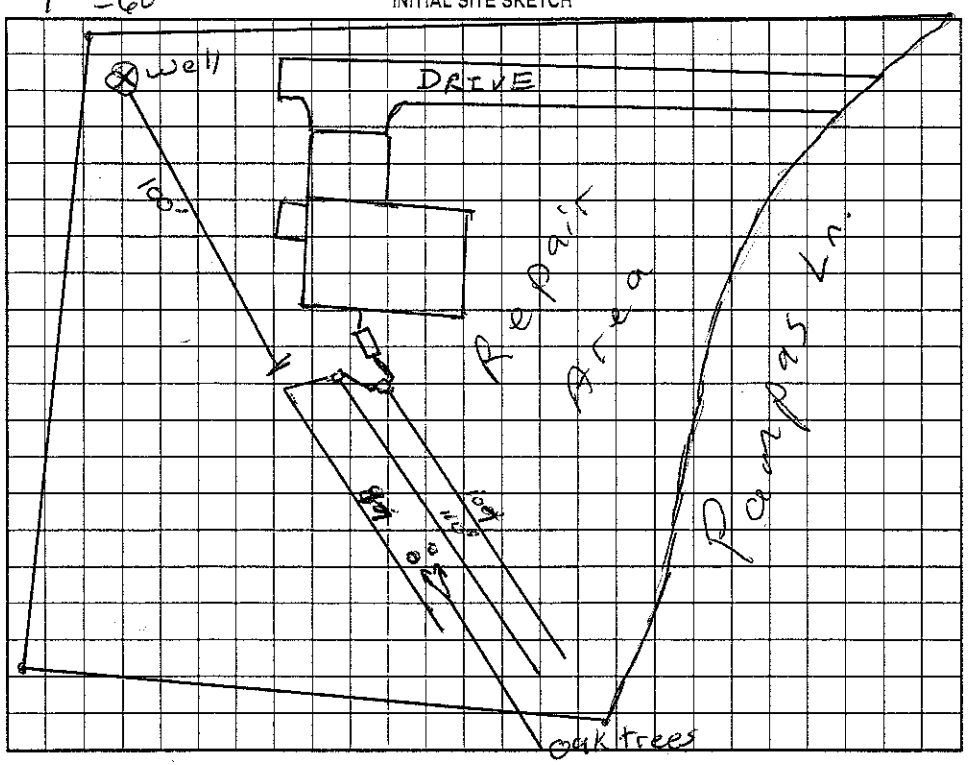

AS BUILT SKETCH

Installed "Plastic Chambers" For Drainfield

Permit can be suspended or revoked if any false information is supplied toward securing the permit/any unauthorized changes are made to the site/any unauthorized changes are made in the installation of the system. Improvement Permit with plat valid without expiration. Improvement Permit with site plan valid for sixty months. Authorization to Construct is valid for a period equal to that of Improvement Permit – not to exceed sixty months.

Signed: [signature] date 9/3/02 Installed by: Rowan Septic

Improvement Permit by: [signature] RS date 9/3/02 Operation Permit by: [signature] RS date 9/6/2002

Authorization to Construct by: [signature] RS date 9/3/02 Existing System Inspection by: date

HEALTH DEPT. COPY: WHITE OWNER COPY (FINAL): YELLOW OWNER COPY (INITIAL): PINK