IREDELL COUNTY HEALTH DEPARTMENT - *ENVIRONMENTAL HEALTH* ☐ STATESVILLE OFFICE 704-878-5305 ☒ MOORESVILLE OFFICE 704-664-5281

IMPROVEMENT PERMIT / AUTHORIZATION TO CONSTRUCT / OPERATION PERMIT / EXISTING SYSTEM INSPECTION

PERMIT # REPAIR PIN # 4657-47-7963 DATE 7-26-11

OWNER RONNIE MANGUM APPLICANT: SAME PHONE: Home/Cell # Business #

SITE ADDRESS 21N, TR BRANTLEY ACRES, OWNER / APPLICANT ADDRESS

SITE DIRECTIONS TR PAMPAS

SUBDIVISION BRANTLEY ACRES BLOCK / SECTION LOT # 5 LOT AREA ~1/2AC DESIGN FLOW 360 L.T.A.R. .4 (PER #1743)

Septic Tank 1000 Gallons: STB 794 Date 4-18-11

Pump Tank Gallons: P T Date

Pump Make Model Serial #

No. Nitrification Fields: No. Lines Linear Feet

Trench Width Max Trench Bottom Depth EXISTING Gravel Depth

☐ New System ☒ Repair ☐ Expansion System Type I II III IV V VI

System Description: TANK

Repair System Description:

Maintenance Agreement Required ☐ YES ☐ NO

☒ GRAVITY ☐ PRESSURE


☒ Residence ☐ Business ☐ Other ☐ Slab ☐ Basement w/plumbing

No. Bedrooms 3 No. Persons No. Employees ☒ Crawl Space ☐ Basement w/o plumbing

Water Supply: ☒ Private ☐ Public ☐ Community

Comments / Conditions (1) INSTALL NEW TANK AS SHOWN

INITIAL SITE SKETCH

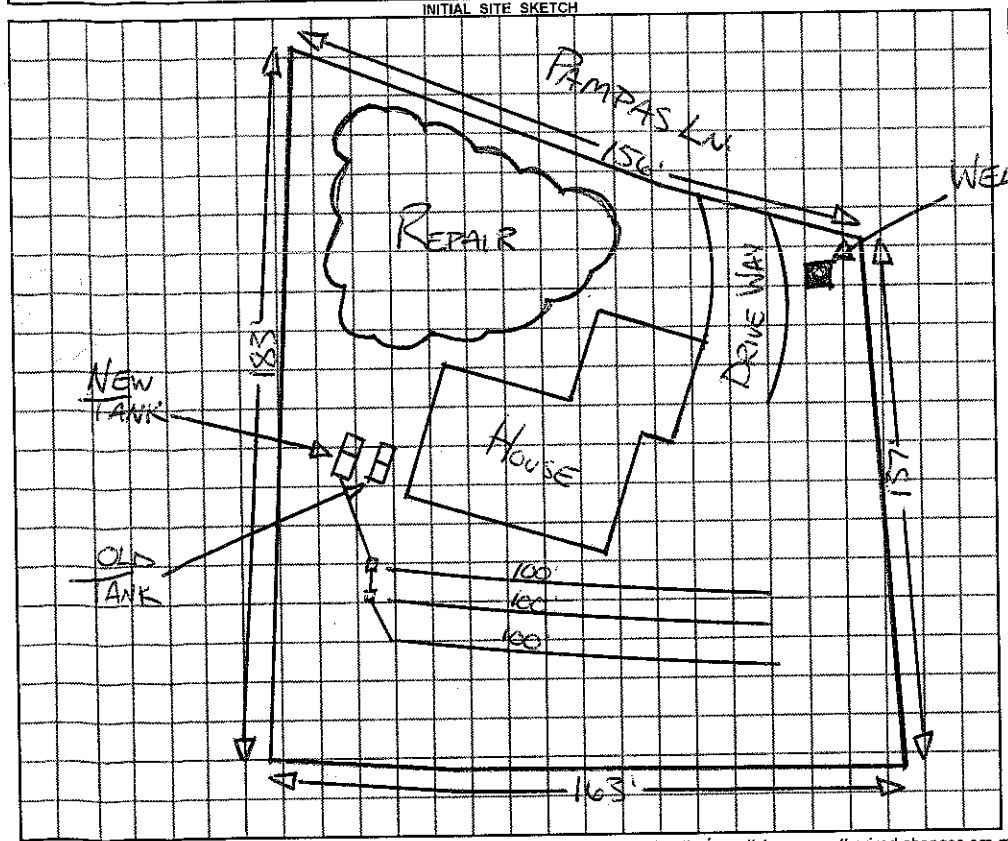

AS BUILT SKETCH

INSTALLED AS SHOWN

Permit can be suspended or revoked if any false information is supplied toward securing the permit / any unauthorized changes are made to the site / any unauthorized changes are made in the installation of the system.

☐ ***IMPROVEMENT PERMIT*** with plat valid without expiration. ☐ ***IMPROVEMENT PERMIT*** with ~~plat valid without expiration~~ site plan valid 60 mo. ☒ ***AUTHORIZATION TO CONSTRUCT*** valid for period equal to IMPROVEMENT PERMIT--not to exceed 60 mo.

Owner / Applicant Signature: Date

IMPROVEMENT PERMIT by: REHS Date 7-26-11

AUTHORIZATION TO CONSTRUCT by: REHS Date 7-26-11

Installed by: LARRY BEAM

OPERATION PERMIT by: REHS Date 7-26-11

Existing System Inspected by: REHS Date

SHOULD CONTACT A LOCATOR SERVICE PRIOR TO ANY EXCAVATION

White Copy – Environmental Health YELLOW COPY (Final) Owner / Applicant PINK COPY (Initial) Owner / Applicant