PIN# 4657-47-9921

IREDELL COUNTY HEALTH DEPARTMENT

STATESVILLE 704-878-5305 MOORESVILLE 704-664-5281

IMPROVEMENT PERMIT / CERTIFICATE OF COMPLETION / OPERATION PERMIT / EXISTING SYSTEM INSPECTION

PROPERTY DESCRIPTION NO. 3108 DATE 1/23/95 TAX MAP NO. 1M 14 B 4 Watershed: ☐ Yes ☒ No

OWNER OR CONTRACTOR Keith Carroll Const. PHONE: Business 664-1155 Home

ADDRESS 795 French Belk Rd. Mt. Ulla, NC. 28125

LOCATION 21N off 150W TR Brantley Acres (R) on Pampas corner lot on (R)

SUBDIVISION Brantley Acres BLOCK / SECTION 1 LOT 4 LOT AREA .47 AC SITE CLASS. P DESIGN FLOW 240 L.T.A.R. .2-.25

Septic Tank: 1000 Gallons; STB 794 Date 4/11/95

Pump Tank: Gallons; PT Date

Pump Make: Model Serial No.

Nitrification Field: No Fields 1 Square Feet 1200 Linear Feet * 200

No Lines 4 Trench Width 24" Max Trench Bottom Depth 36" Gravel Depth 6" SAND

☒ New System ☐ Repair System Type: I, II (III) IV, V, VI

System Description: PPBS-GRAVITY

Repair System Description: SAME

Maintenance Agreement Required: ☐ Yes ☒ No

☒ House/Mod. Home No. Bedrooms 2

☐ Mobile Home No. Bathrooms 2

☐ Business No. Employees

☐ Other


☐ Slab ☒ Crawl Space ☐ Basement w/plumbing ☐ Basement wo/plumbing

Water Supply: ☒ Individual ☐ Community ☐ Public

Comments: Well 25' minimum from foundation
Very tight no room for error. * House location
Dimensions should be followed

Comments: Changes in Lt. Blue

INITIAL SITE SKETCH

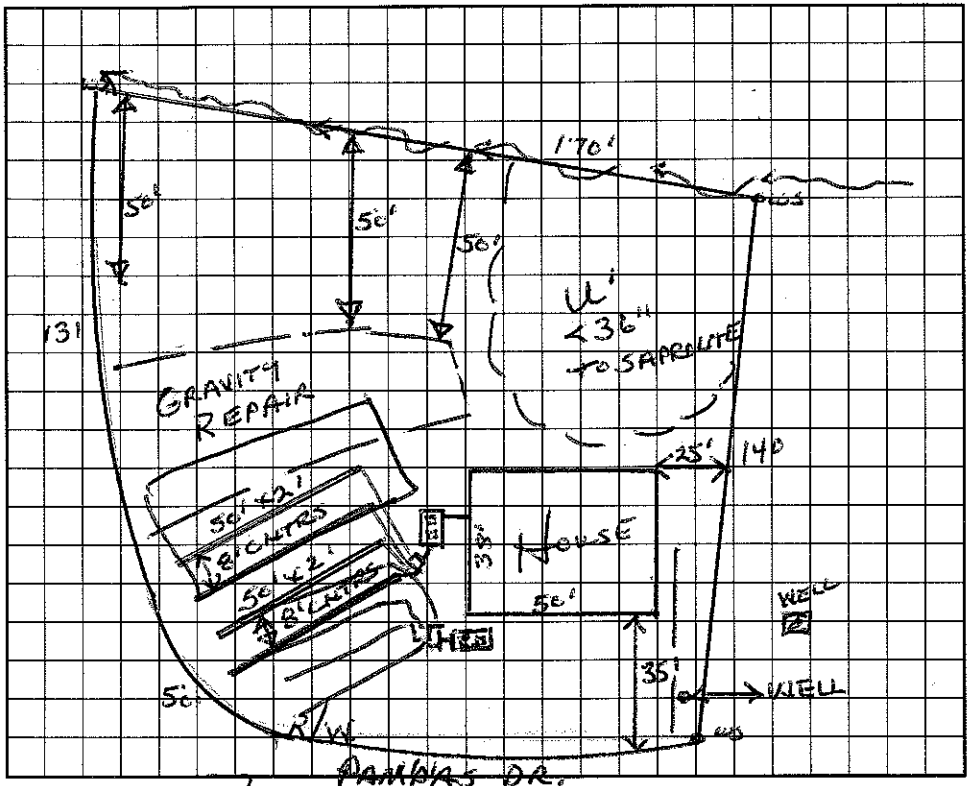

AS BUILT SKETCH

I understand that this permit can be suspended or revoked if any false information is supplied toward securing the permit/any unauthorized changes are made to the site/any unauthorized changes are made in the installation of the system. Improvement Permit is valid for 60 months from date of issuance.

Signed:

Improvement Permit by: Wesley Sparks RS. date 1/23/95

Existing System Inspection by: date

Installed by: F J Ervin

Certificate of Completion by: Wesley Sparks RS. date 6/28/95

Operation Permit by: date

HEALTH DEPT. COPY: WHITE INSPECTION COPY (FINAL): GREEN OWNER COPY (FINAL): YELLOW INSPECTION COPY (INITIAL): PINK OWNER COPY (INITIAL): GOLD