IREDELL COUNTY HEALTH DEPARTMENT

STATESVILLE 704-878-5305 MOORESVILLE 704-664-5281

Paid 300.00 2.00

IMPROVEMENT PERMIT / AUTHORIZATION TO CONSTRUCT / OPERATION PERMIT / EXISTING SYSTEM INSPECTION

PERMIT# 7543 / 116500 PIN# 4657480456 DATE March 26, 01

OWNER OR CONTRACTOR John Dodson PHONE: Business 663-2239; 663-6670 Home

ADDRESS 123 Summerchase Ln. Mooresville, NC 28117

LOCATION 21N TR Brantley Acres DR ON left

SUBDIVISION Brantley Acres BLOCK / SECTION LOT 2 LOT AREA 106.5' X 207' SITE CLASS. PS DESIGN FLOW 360 gpd L.T.A.R. .3

Septic Tank: 1000 Gallons; STB 312 Date 4/21/04

Pump Tank: Gallons; PT Date

Pump Make: Model Serial No.

Nitrification Field: No Fields 1 Square Feet 900 Linear Feet 300

No Lines 3 Trench Width 36" Max Trench Bottom Depth 36 Gravel Depth NA

☑ New System ☐ Repair System Type: I, II, (III), IV, V, VI

System Description: Conv. w/ Innovative - 25% Red

Repair System Description: pumped Innovative

Maintenance Agreement Required: ☐ Yes ☑ No

☑ House/Mod. Home No. Bedrooms 3

☐ Mobile Home No. Bathrooms 2

☐ Business No. Employees

☐ Other

☐ Slab ☑ Crawl Space ☐ Basement w/plumbing ☐ Basement wo/plumbing


Water Supply: ☑ Individual ☐ Public ☐ Community

Comments:/Conditions: Do Not cut Lower house site. Exit plumbing at/near existing grade where septic tank is shown.

Comments:/Conditions:

INITIAL SITE SKETCH

1"=50'

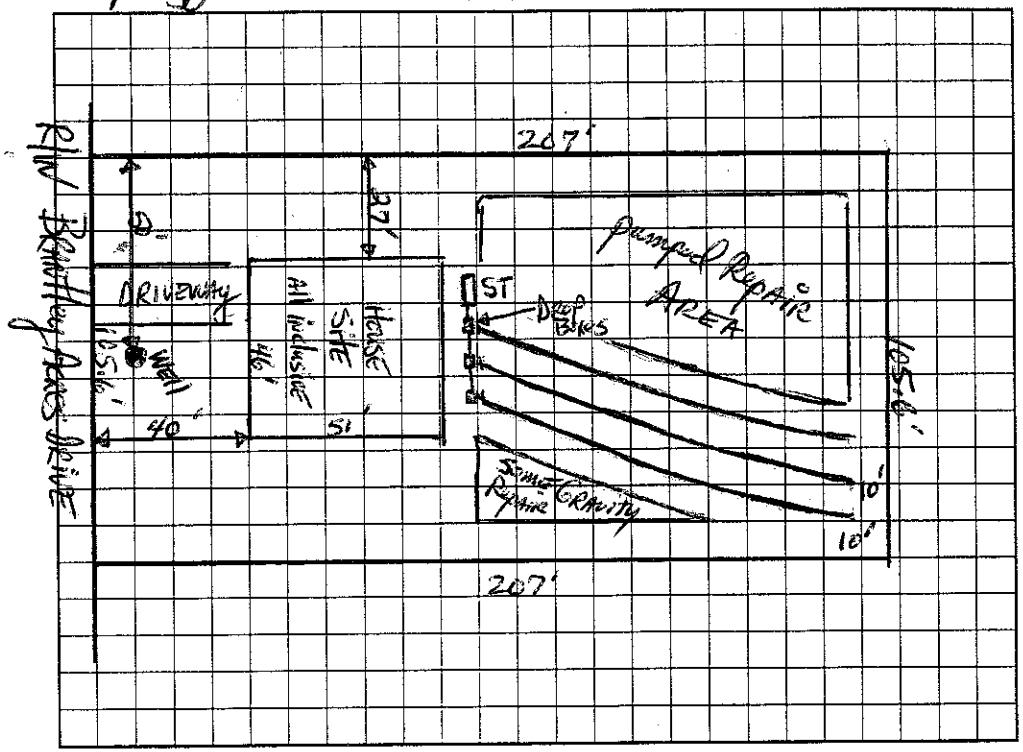

AS BUILT SKETCH

EZ Flow Installed As Drawn

Permit can be suspended or revoked if any false information is supplied toward securing the permit/any unauthorized changes are made to the site/any unauthorized changes are made in the installation of the system. Improvement Permit with plat valid without expiration. Improvement Permit with site plan valid for sixty months. Authorization to Construct is valid for a period equal to that of Improvement Permit – not to exceed sixty months.

Signed: date 3-30-01

Improvement Permit by: date 3-26-01

Authorization to Construct by: date 3-26-01

Installed by: Larry Beam

Operation Permit by: RS date 6/18/04

Existing System Inspection by: date

HEALTH DEPT. COPY: WHITE OWNER COPY (FINAL): YELLOW OWNER COPY (INITIAL): PINK