IREDELL COUNTY HEALTH DEPARTMENT

STATESVILLE 704-878-5305 MOORESVILLE 704-664-5281

IMPROVEMENT PERMIT / CERTIFICATE OF COMPLETION / OPERATION PERMIT / EXISTING SYSTEM INSPECTION

PROPERTY DESCRIPTION NO. 2836 DATE JULY 1, 1994 TAX MAP NO. IL A 13 C 4657 48 3426 Watershed: ☐ Yes ☐ No

OWNER OR CONTRACTOR KEITH CARROLL PHONE: Business 664-1155 Home

ADDRESS 795 FRENCH BELK ROAD NT ULLA NC 28125

LOCATION N on hwy 21 from hwy 150, N 1/4 mile on right (eastside) to private road, Brantley Acres Road, lot on right before fork

SUBDIVISION Brantley Acres BLOCK / SECTION LOT 1 LOT AREA 20,000 M² SITE CLASS. P DESIGN FLOW 360 L.T.A.R. 0.3

Septic Tank: 1000 Gallons; STB Date

Pump Tank: 1000 Gallons; PT Date

Pump Make: Model Serial No.

Nitrification Field: No Fields 1 Square Feet 1200 Linear Feet 400

No Lines 3 Trench Width 36" Max Trench Bottom Depth 24" Gravel Depth 12"

☑ New System ☐ Repair System Type: I, II, III, IV, V, VI

System Description: pump to gravity conventional

Repair System Description: same

Maintenance Agreement Required: ☐ Yes ☑ No

☑ House/Mod. Home No. Bedrooms 3

☐ Mobile Home No. Bathrooms 2

☐ Business No. Employees

☐ Other


☐ Slab ☑ Crawl Space ☐ Basement w/plumbing ☐ Basement wo/plumbing

Water Supply: ☑ Individual ☐ Community ☐ Public

Comments: ① PUMP LINE RUN UP CENTER, UNDER OR BESIDE TEES ② GATE VALVE IN D.BOX OR WASHER BOX, THREE OUTLETS FROM A D.BOX EACH TO A FLOW DIRECTOR TEE. ③ SOLID EARTH DAM MIN 2' WIDE BETWEEN TEE AND NT. LINE. CONTACT DEPT PRIOR TO EXCAVATION TO CONFIRM LAYOUT.

Comments:

INITIAL SITE SKETCH

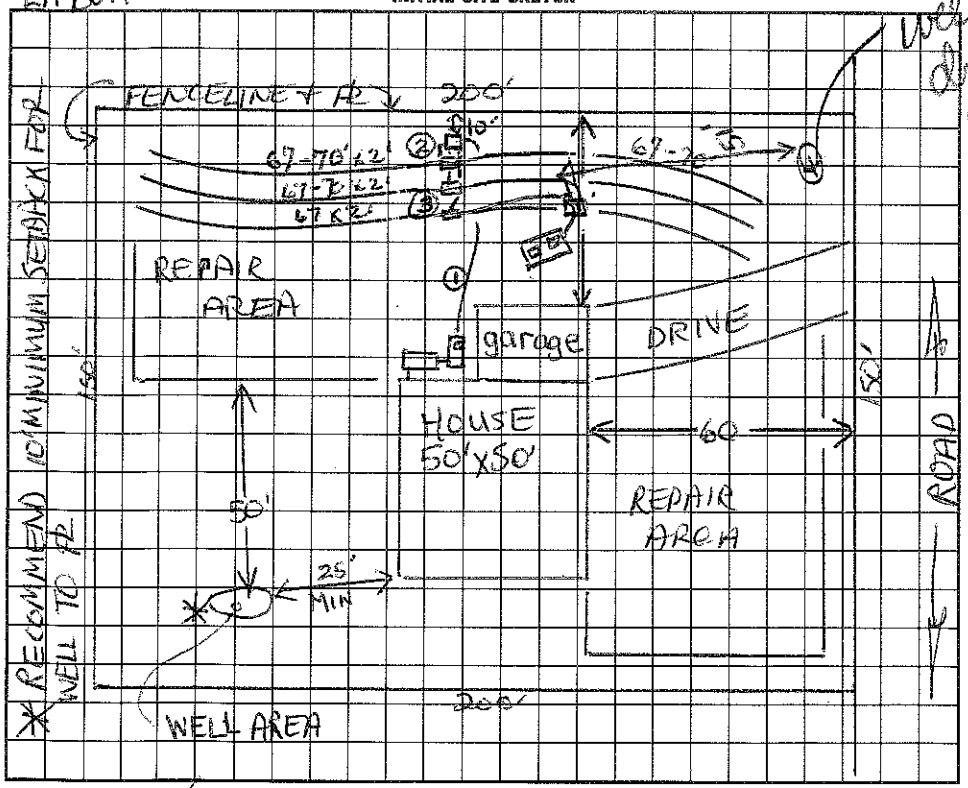

well was drilled June 1994 approved 7/95 DHM

AS BUILT SKETCH

I understand that this permit can be suspended or revoked if any false information is supplied toward securing the permit/any unauthorized changes are made to the site/any unauthorized changes are made in the installation of the system. Improvement Permit is valid for 60 months from date of issuance.

Signed:

Improvement Permit by: Andrea Lemon date 7-1-94

Existing System Inspection by: date

Installed by: F J Ervin

Certificate of Completion by: Wesley Sparks RS date 3/31/95

Operation Permit by: date

HEALTH DEPT. COPY: WHITE INSPECTION COPY (FINAL): GREEN OWNER COPY (FINAL): YELLOW INSPECTION COPY (INITIAL): PINK OWNER COPY (INITIAL): GOLD