IREDELL COUNTY HEALTH DEPARTMENT

Authorization to Construct

ATESVILLE 704-878-5305 MOORESVILLE 704-664-5281

IMPROVEMENT PERMIT / ~~CERTIFICATE OF COMPLETION~~ / OPERATION PERMIT / EXISTING SYSTEM INSPECTION

PROPERTY DESCRIPTION NO. 5076 DATE 10/27/97 TAX MAP NO. 4659481625 Watershed: ☐ Yes ☒ No

OWNER OR CONTRACTOR Brian Newmen PHONE: Business 663-5707 Home 664-1927

ADDRESS 147 Freunds Ln. Mooresville, NC. 28115

LOCATION 150 ON TR 2 IN TR Summerchase to cul de sac straight off cul de sac

SUBDIVISION Summerchase BLOCK / SECTION _____ LOT 3 LOT AREA .88 AC SITE CLASS PS DESIGN FLOW 360 L.T.A.R. .3

Septic Tank: 1000 Gallons; STB 1012 Date 4/21/98

Pump Tank: _____ Gallons; PT _____ Date _____

Pump Make: _____ Model _____ Serial No. _____

Nitrification Field: No Fields 1 Square Feet 900± Linear Feet 300±

No Lines 4 Trench Width 36" Max Trench Bottom Depth 36" Gravel Depth SAND

☒ New System ☐ Repair System Type: I, II, ☒ III, IV, V, VI

System Description: GRAV - CH, PLASTIC

Repair System Description: SAME

Maintenance Agreement Required: ☐ Yes ☒ No

☒ House/Mod. Home No. Bedrooms 3

☐ Mobile Home No. Bathrooms 3

☐ Business No. Employees _____


☐ Other _____

☐ Slab ☒ Crawl Space ☐ Basement w/plumbing ☐ Basement wo/plumbing

Water Supply: ☒ Individual ☐ Community ☐ Public

Comments:

INITIAL SITE SKETCH

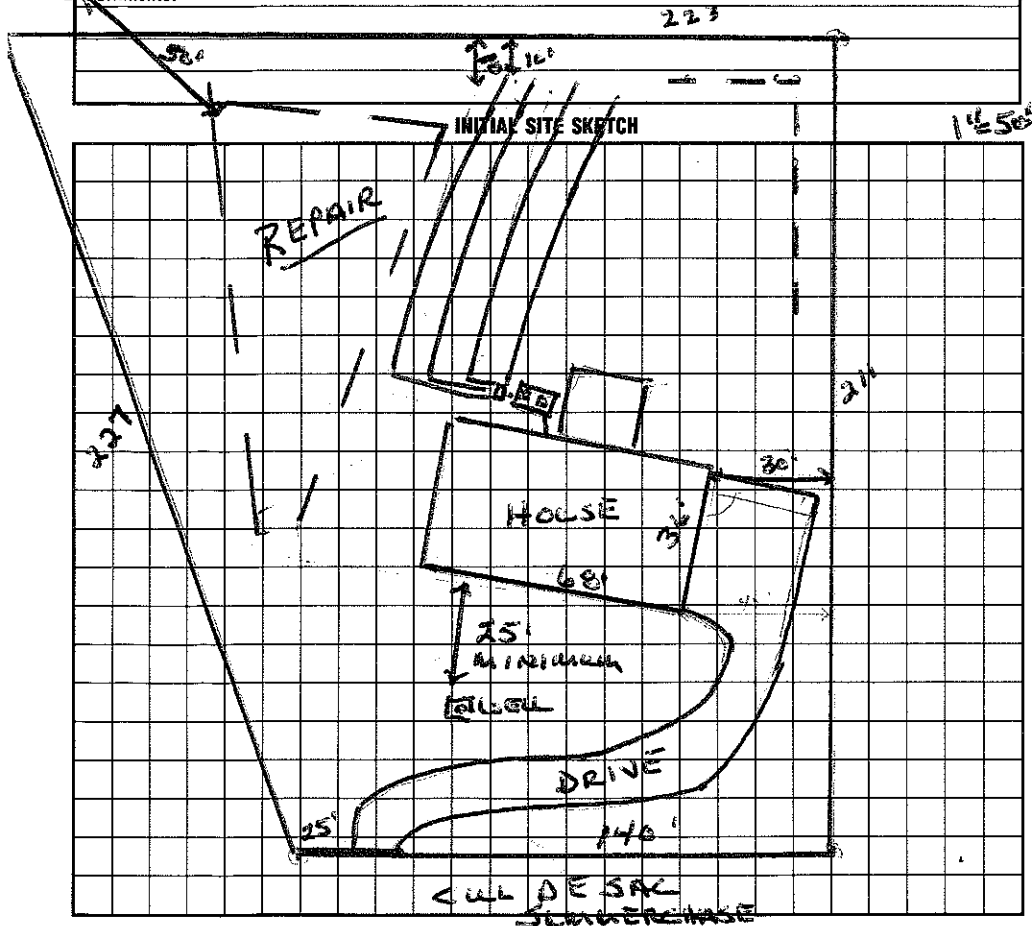

Comments:

AS BUILT SKETCH

I understand that this permit can be suspended or revoked if any false information is supplied toward securing the permit/any unauthorized changes are made to the site/any unauthorized changes are made in the installation of the system. Improvement Permit is valid for 60 months from date of issuance.

Signed: [signature]

Improvement Permit by: Wesley Sparks RS. date 10/27/97

~~Existing System Inspection~~ by: Wesley Sparks RS. date 10/27/97

Installed by: TOMMY FRYE

Certificate of Completion by: _____ date _____

Operation Permit by: [signature] date 6/23/98

HEALTH DEPT. COPY: WHITE INSPECTION COPY (FINAL): GREEN OWNER COPY (FINAL): YELLOW INSPECTION COPY (INITIAL): PINK OWNER COPY (INITIAL): GOLD