4657 48 3637

IREDELL COUNTY HEALTH DEPARTMENT

(SEPTIC TANK) IMPROVEMENTS PERMIT AND CERTIFICATE OF COMPLETION
(Ground Absorption Sewage Disposal System -- G. S. Chapter 130-Article 13C)

OWNER OR CONTRACTOR Keith Carroll DATE 11/29/88 PERMIT NO. 18D

PHONE: Business _____ Home _____

LOCATION 21N. TR past water treatment plant (b/f Oates Rd.) on L.

SUBDIVISION NAME Brantley property LOT NO. _____ SECTION OR BLOCK NO. _____ S. R. No. _____

House (✓) Mobile Home ( ) Business ( ) Other _____


No. Bedrooms 3 No. Bathrooms 2

Garbage Disposal Unit	Yes ( )	No (✓)	
Auto. Dishwasher	Yes (✓)	No ( )	
Auto. Wash. Machine	Yes (✓)	No ( )	
~~Site Suitable~~ P.S.	Yes (✓)	No ( )	

Lot Area ~1 ACRE

Character & Porosity of Soil clay
Percolation Rate ~35
Topography 4-6%
Depth to Water Table 4'+
Rock or other impervious formations none obs.

_____ Basement with Plumbing _____ Basement without Plumbing ✓ No Basement

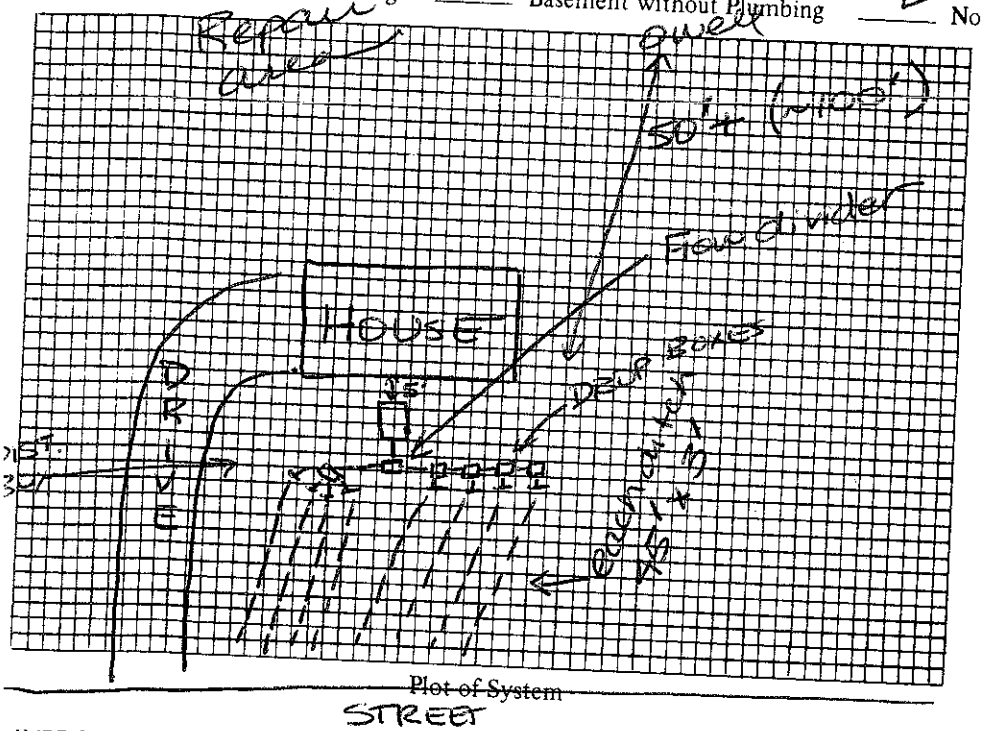

Size of Tank 1000 Gals.
Nitrification Field:
No. of Lines 8
Sq. Ft. 1080 Linear Ft. 360
Depth of Stone in Lines 12"
Water Supply: Individual (✓)
Public ( )

Installed by E J ERVIN

I understand and agree to install septic tank system as specified on this Improvements Permit.

Signed: _____

IMPROVEMENTS PERMIT BY DRH

COMMENTS: house was moved from layout. Alterations in installation resulted from this moves.

CERTIFICATE OF COMPLETION BY Andre C Pierce

EXISTING SYSTEM CHECKED BY: _____ DATE 11/29/88

CONSTRUCTION MUST COMPLY WITH ALL OTHER APPLICABLE STATE AND LOCAL REGULATIONS. DATE _____

Permit is VOID if any unauthorized changes are made in installation of system and/or if any false information is supplied in making Improvements Permit.

Health Dept. Copy: White Inspection Dept. Copy: Yellow Sanitarian's Copy: Pink Owner's Copy: Gold

0991

IREDELL COUNTY HEALTH DEPARTMENT

(SEPTIC TANK) IMPROVEMENTS PERMIT AND CERTIFICATE OF COMPLETION

(Ground Absorption Sewage Disposal System -- G. S. Chapter 130-Article 13C)

OWNER OR CONTRACTOR Keith Carroll DATE Sept. 21, 88 PERMIT NO. 180

PHONE: Business _____ Home _____

LOCATION 21 N. TR past water treatment plant (before Oaks Rd.) on left

SUBDIVISION NAME Brantley property LOT NO. _____ SECTION OR BLOCK NO. _____ S. R. No. _____

House (✓) Mobile Home ( ) Business ( ) Other _____

No. Bedrooms 3 No. Bathrooms 2

Garbage Disposal Unit	Yes ( )	No (✓)
Auto. Dishwasher	Yes (✓)	No ( )
Auto. Wash. Machine	Yes (✓)	No ( )
Site Suitable	Yes (✓)	No ( )

Lot Area 2 1/4c

Character & Porosity of Soil Clay


Percolation Rate 2, 35

Topography 4 to 6%

Depth to Water Table 4'+

Rock or other impervious formations none to 4'

_____ Basement with Plumbing _____ Basement without Plumbing ✓ No Basement

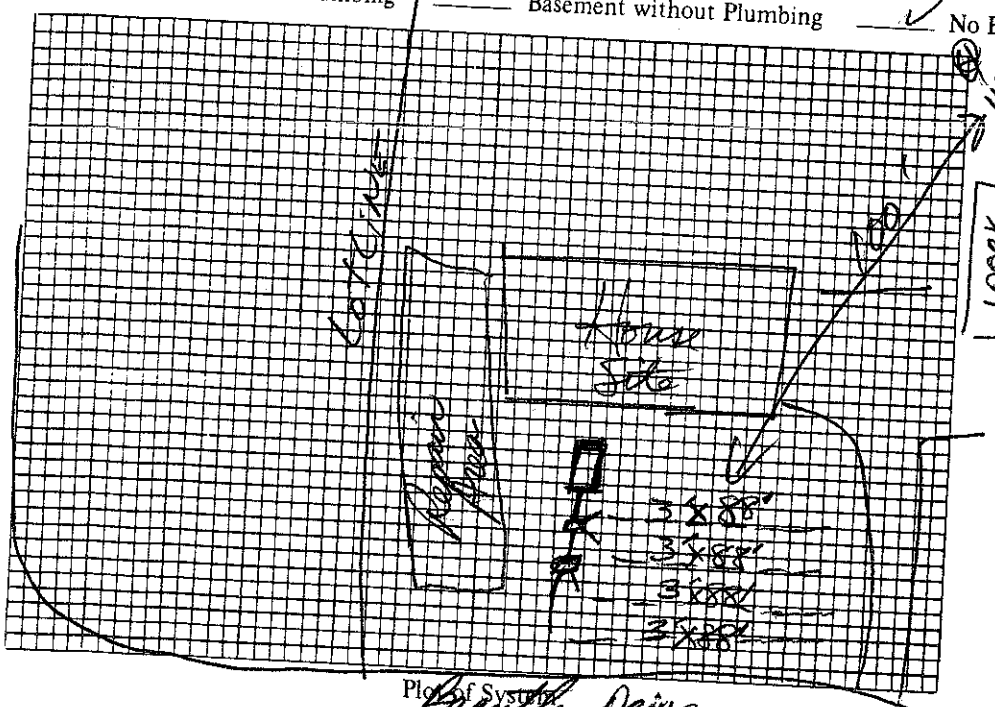

Size of Tank 1000 Gals.

Nitrification Field:
No. of Lines 4
Sq. Ft. 1050 Linear Ft. 350
Depth of Stone in Lines 12"

Water Supply: Individual (✓)
Public ( )

Installed by _____

I understand and agree to install septic tank system as specified on this Improvements Permit.

Signed: ~~X~~ Keith Carroll

Plot Plan of System

IMPROVEMENTS PERMIT BY DK Hanbor, RS.

COMMENTS: Area of drainfield to be slightly sloped in order to provide fairly level grade for drainfield. Max trench depth 30" to ditch bottom. WD stepdowns!

CERTIFICATE OF COMPLETION BY _____

EXISTING SYSTEM CHECKED BY: _____ DATE _____

CONSTRUCTION MUST COMPLY WITH ALL OTHER APPLICABLE STATE AND LOCAL REGULATIONS. DATE _____

ermit is VOID if any unauthorized changes are made in installation of system and/or if any false information is supplied in making nprovements Permit.

Health Dept. Copy: White Inspection Dept. Copy: Yellow Sanitarian's Copy: Pink Owner's Copy: Gold