IREDELL COUNTY HEALTH DEPARTMENT

STATESVILLE 704-878-5305 MOORESVILLE 704-664-5281

IMPROVEMENT PERMIT / CERTIFICATE OF COMPLETION / OPERATION PERMIT / EXISTING SYSTEM INSPECTION

PROPERTY DESCRIPTION NO. 3231 DATE 5/4/95 TAX MAP NO. Pt of 1M14A3 4657-48-4808 Watershed: ☐ Yes ☑ No

OWNER OR CONTRACTOR Tom Cogdill PHONE: Business _____ Home 664-3233

ADDRESS 171 Brantley Acres Mooresville, NC. 28115

LOCATION Brantley Acres TL on Pampas to 2nd house on (L)

SUBDIVISION _____ BLOCK / SECTION _____ LOT _____ LOT AREA _____ SITE CLASS. P DESIGN FLOW 240 L.T.A.R. .3 - .35

Septic Tank: 1000 Gallons; STB 794 Date 10-6-95

Pump Tank: 1000 Gallons; PT 27 Date 9-6-95

Pump Make: Liberty Model LE5IA Serial No. 27801

Nitrification Field: No Fields 1 Square Feet 720 Linear Feet 240

No Lines 3 Trench Width 36" Max Trench Bottom Depth 36" Gravel Depth 12"

☑ New System ☐ Repair System Type: I, II, (III), IV, V, VI

System Description: Pressure Conventional -

Repair System Description: _____

Maintenance Agreement Required: ☑ Yes ☐ No 5 YRS.

☑ House/Mod. Home No. Bedrooms 2

☐ Mobile Home No. Bathrooms 2

☐ Business No. Employees ____

☐ Other _____


☐ Slab ☐ Crawl Space ☑ Basement w/plumbing ☐ Basement wo/plumbing

Water Supply:
☑ Individual
☐ Community
☐ Public
Cogdill

Comments:

Comments: Checked ST, PT, Floats, pressure head, and drainlines on 12-29-95. Checked Alarm, NEMA 4X Box, on _____.

INITIAL SITE SKETCH

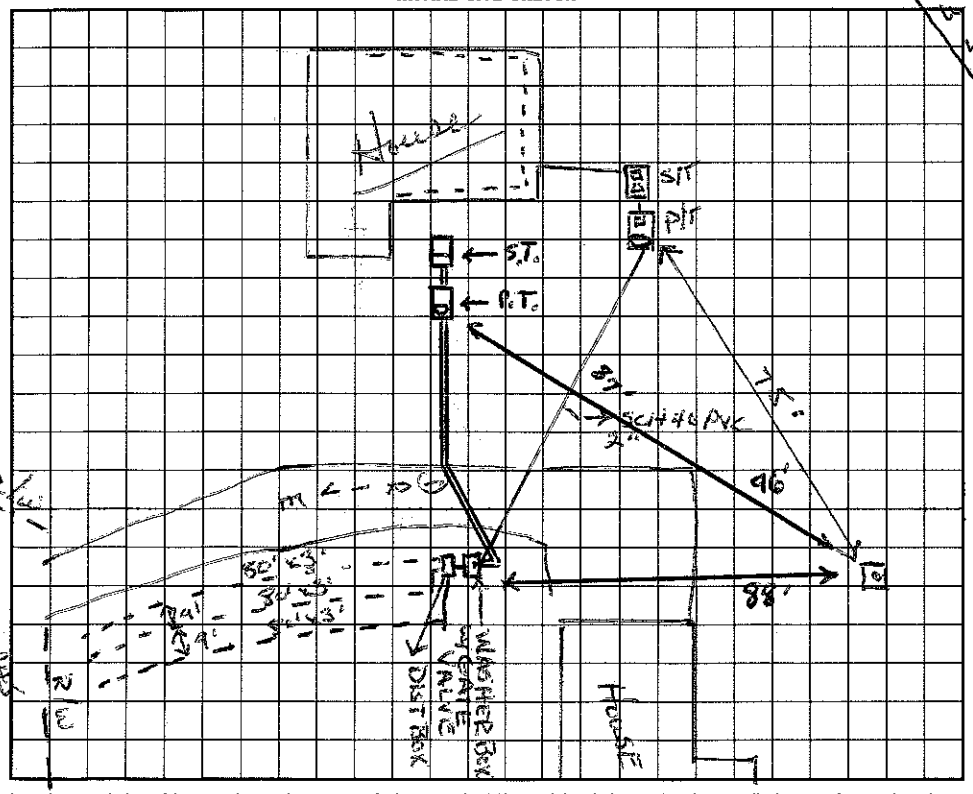

AS BUILT SKETCH

SAME AS INITIAL SKETCH

except: Tanks located in diff. location. They are shown on initial sketch.

I understand that this permit can be suspended or revoked if any false information is supplied toward securing the permit/any unauthorized changes are made to the site/any unauthorized changes are made in the installation of the system. Improvement Permit is valid for 60 months from date of issuance.

Signed: X Tom Cogdill

Improvement Permit by: Wesley Sparks RS. date 5/4/95

Existing System Inspection by: _____ date _____

Installed by: C. Wayne Orbison & Sons.

Certificate of Completion by: Wesley Sparks RS. date 1/16/96

Operation Permit by: Wesley Sparks RS date 1/16/96

HEALTH DEPT. COPY: WHITE INSPECTION COPY (FINAL): GREEN OWNER COPY (FINAL): YELLOW INSPECTION COPY (INITIAL): PINK OWNER COPY (INITIAL): GOLD