COPY

IREDELL COUNTY HEALTH DEPARTMENT

STATESVILLE 704-878-5305 MOORESVILLE 704-664-5281

IMPROVEMENT PERMIT / AUTHORIZATION TO CONSTRUCT / OPERATION PERMIT / EXISTING SYSTEM INSPECTION

PERMIT# 135354 PIN# 4657485359 DATE 5/4/06

OWNER OR APPLICANT Tara Lynn Heaton PHONE: Business 704-607-8904 Home

ADDRESS 148 Brantley Acres Rd. Mooresville, NC. 28115

LOCATION 2/N TR Brantley Acres TL Brantley Acres, 1st lot on (R)

SUBDIVISION Brantley Acres BLOCK / SECTION LOT 11 LOT AREA 1.78Ac SITE CLASS. PS DESIGN FLOW 360 L.T.A.R.

Septic Tank: EXISTING Gallons: STB Date

Pump Tank: Gallons: PT Date

Pump Make: Model Serial No.

Nitrification Field: No Fields Square Feet EXISTING Linear Feet

No Lines Trench Width Max Trench Bottom Depth Gravel Depth ☐ Gravity ☐ Pressure

☐ New System ☐ Repair ☐ Expansion System Type: I (II) III IV V VI

System Description:

Repair System Description: EXISTING

Maintenance Agreement Required: ☐ Yes ☐ No

(X) House/Mod. Home No. Bedrooms 3

☐ Mobile Home No. Persons 3

☐ Business No. Employees

☐ Other


Water Supply: (X) Individual ☐ Public ☐ Community

☐ Slab ☐ Crawl Space (X) Basement w/plumbing ☐ Basement wo/plumbing


Comments:/Conditions:

Comments:/Conditions:

INITIAL SITE SKETCH

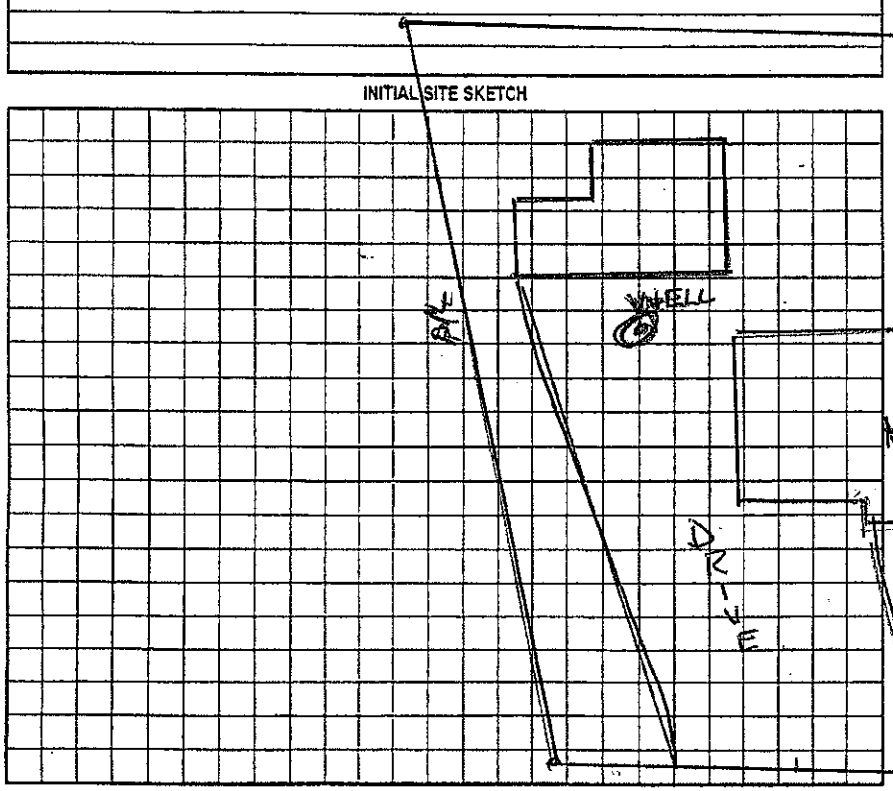

AS BUILT SKETCH

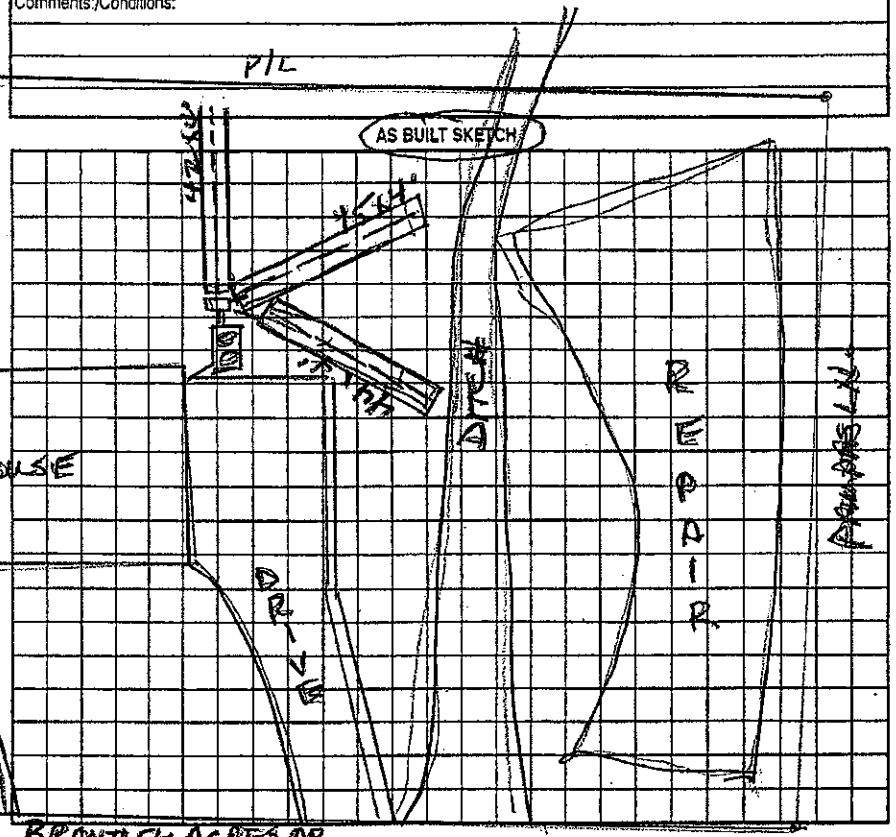

Permit can be suspended or revoked if any false information is supplied toward securing the permit/any unauthorized changes are made to the site/any unauthorized changes are made in the installation of the system. Improvement Permit with plat valid without expiration ☐ Improvement Permit with site plan valid for sixty months ☐ Authorization to Construct is valid for a period equal to that of Improvement Permit – not to exceed sixty months.

Signed: Tara Lynn Heaton date 5/8/06 Installed by:

Improvement Permit by: date Operation Permit by: date

Authorization to Construct by: date Existing System Inspection by: Wesley Sparks date 5/4/06

HEALTH DEPT. COPY: WHITE OWNER COPY (FINAL): YELLOW OWNER COPY (INITIAL): PINK