IREDELL COUNTY HEALTH DEPARTMENT

STATESVILLE 704-878-5305 MOORESVILLE 704-664-5281

PIN# 4657-48-5661

IMPROVEMENT PERMIT / CERTIFICATE OF COMPLETION / OPERATION PERMIT / EXISTING SYSTEM INSPECTION

PROPERTY DESCRIPTION NO. 2955 DATE 9/28/94 TAX MAP NO. 1M 14B 10 Watershed: ☐ Yes ☑ No

OWNER OR CONTRACTOR Bucky Wichser PHONE: Business _____ Home 662-3362

ADDRESS Rt 4 Box 1011 Mooresville, NC.

LOCATION Brantley Acres, 2i N TR on Brantley TR Perfect TR to 1st on old dead end R

SUBDIVISION Brantley Acres BLOCK / SECTION _____ LOT 10 LOT AREA 1.79 Ac SITE CLASS. P DESIGN FLOW 450 L.T.A.R. .3

Septic Tank: 1000 Gallons; STB 794 Date 1/19/95

Pump Tank: _____ Gallons; PT _____ Date _____

Pump Make: _____ Model _____ Serial No. _____

Nitrification Field: No Fields 1 Square Feet 1600 Linear Feet ~~*~~ 266

No Lines 4 Trench Width 24" Max Trench Bottom Depth 36" Gravel Depth 12" STONE

☑ New System ☐ Repair System Type: I, II, III, IV, V, VI

System Description: GRAVITY Panel

Repair System Description: _____

Maintenance Agreement Required: ☐ Yes ☐ No

☑ House/Mod. Home No. Bedrooms 4

☐ Mobile Home No. Bathrooms 2.5

☐ Business No. Employees _____

☐ Other _____


☐ Slab ☐ Crawl Space ☐ Basement w/plumbing ☑ Basement wo/plumbing

Water Supply: ☑ Individual ☐ Community ☐ Public


Comments:

Comments:

INITIAL SITE SKETCH

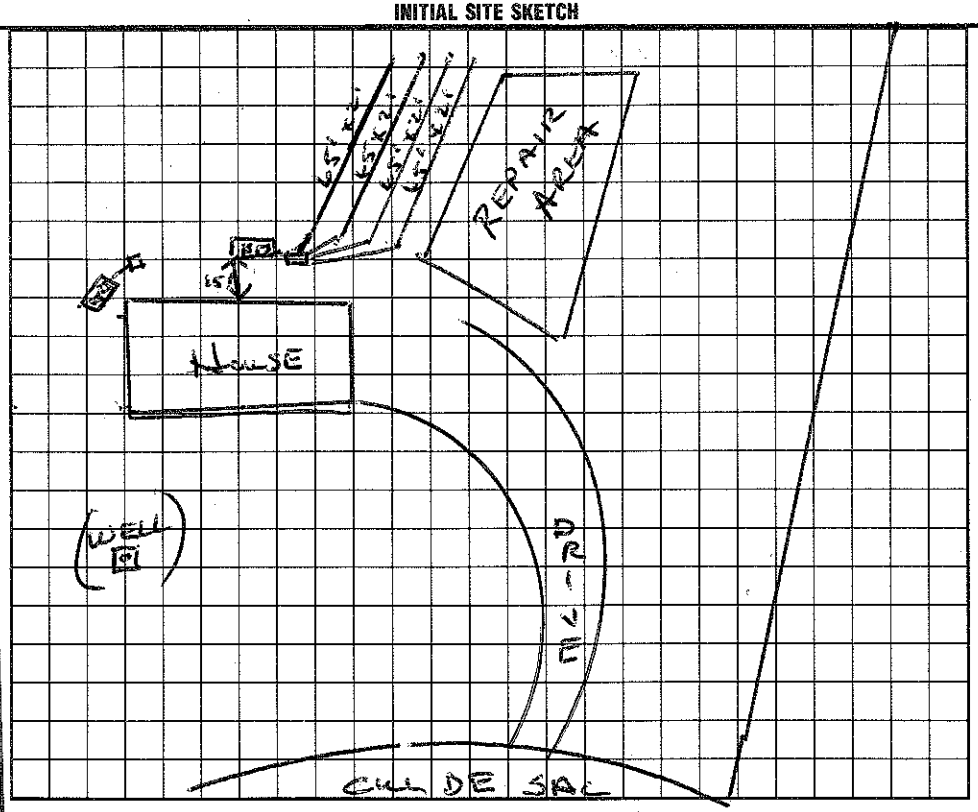

AS BUILT SKETCH

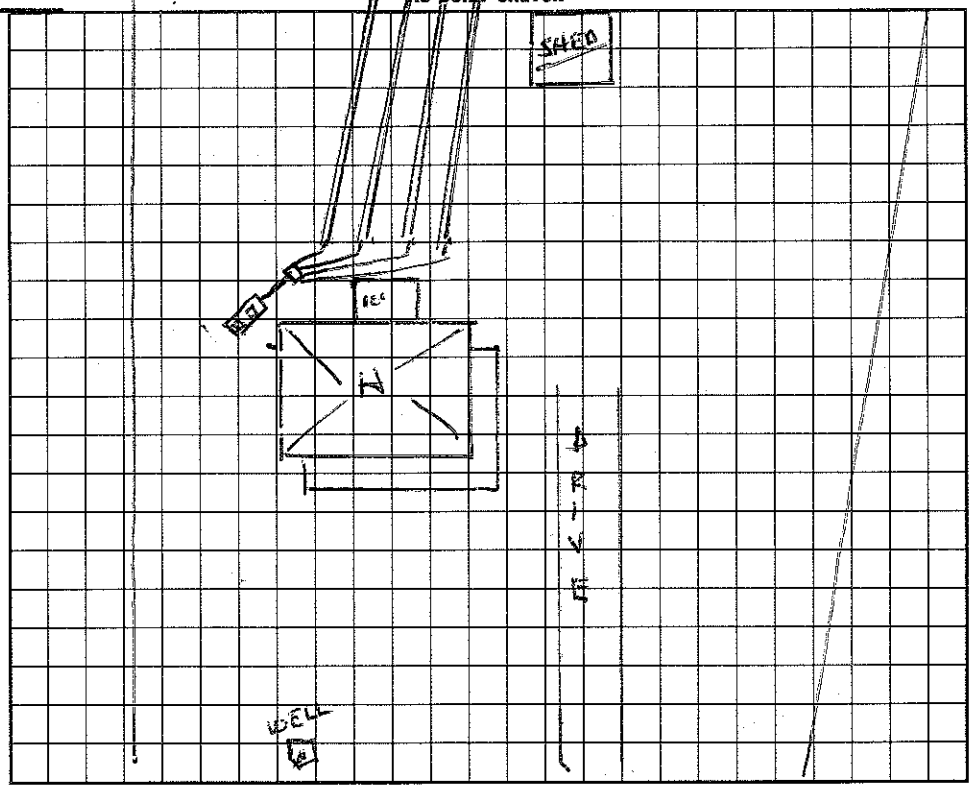

I understand that this permit can be suspended or revoked if any false information is supplied toward securing the permit/any unauthorized changes are made to the site/any unauthorized changes are made in the installation of the system. Improvement Permit is valid for 60 months from date of issuance.

Signed: _____

Improvement Permit by: Wesley Sparkes RS. date 9/28/94

Existing System Inspection by: Bucky Wichser date _____

Installed by: Richard Abernathy

Certificate of Completion by: Wesley Sparkes. date 3/28/95

Operation Permit by: _____ date _____

HEALTH DEPT. COPY: WHITE INSPECTION COPY (FINAL): GREEN OWNER COPY (FINAL): YELLOW INSPECTION COPY (INITIAL): PINK OWNER COPY (INITIAL): GOLD