IREDELL COUNTY HEALTH DEPARTMENT

STATESVILLE 704-878-5305 MOORESVILLE 704-664-5281

IMPROVEMENT PERMIT / CERTIFICATE OF COMPLETION / OPERATION PERMIT / EXISTING SYSTEM INSPECTION

PROPERTY DESCRIPTION NO. 3095 DATE 1/12/95 TAX MAP NO. 1M 14 B8 / 4657-57-0446 Watershed: ☐ Yes ☒ No

OWNER OR CONTRACTOR Lynn & Jana Adams PHONE: Business _____ Home _____

ADDRESS PO Box 94 Mooresville, NC. 28115

LOCATION Brantley Acres, 21N R on Brantley (R) on Jones (R) on Jones Rd to cul de sac

SUBDIVISION Brantley Acres BLOCK / SECTION _____ LOT 8 LOT AREA 1.99 Ac. SITE CLASS. P DESIGN FLOW 360 L.T.A.R. .3

Septic Tank: 1000 Gallons; STB 794 Date 4/9/95

Pump Tank: _____ Gallons; PT _____ Date _____

Pump Make: _____ Model _____ Serial No. _____

Nitrification Field: No Fields 1 Square Feet 1200 Linear Feet 400

No Lines 3@4 Trench Width 36" Max Trench Bottom Depth 36" Gravel Depth 12"

☒ New System ☐ Repair System Type: I, (II) III, IV, V, VI

System Description: DIST BOX - CONVENTIONAL

Repair System Description: _____

Maintenance Agreement Required: ☐ Yes ☒ No

☒ House/Mod. Home No. Bedrooms 3

☐ Mobile Home No. Bathrooms 2

☐ Business No. Employees _____

☐ Other _____


☐ Slab ☐ Crawl Space ☒ Basement w/plumbing ☐ Basement wo/plumbing

Water Supply:
☒ Individual
☐ Community
☐ Public


Comments:

Comments:
Dutton drains run below drainfield
Diversion ditch needs to be added upslope from drainfield area.

INITIAL SITE SKETCH

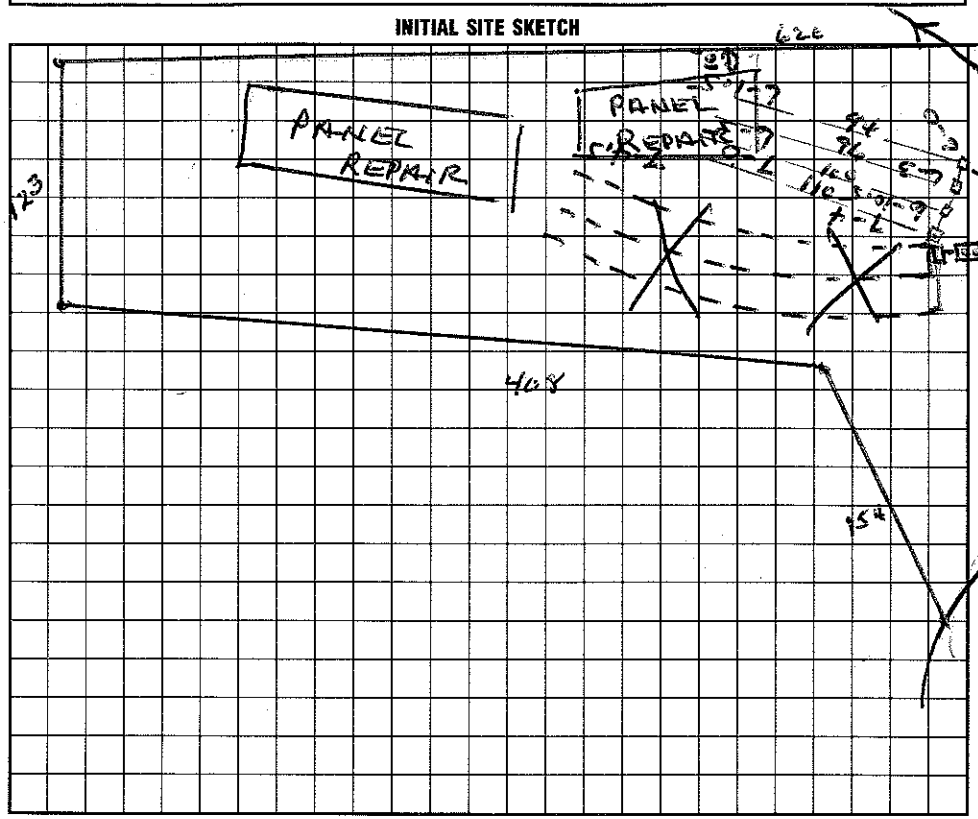

AS BUILT SKETCH

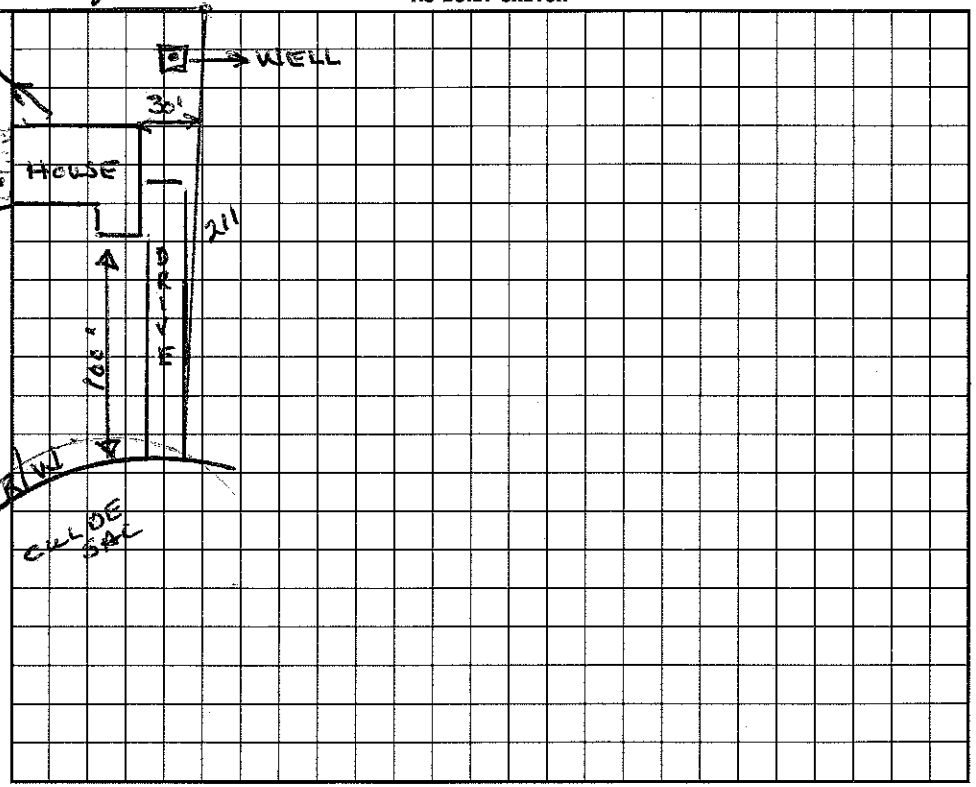

I understand that this permit can be suspended or revoked if any false information is supplied toward securing the permit/any unauthorized changes are made to the site/any unauthorized changes are made in the installation of the system. Improvement Permit is valid for 60 months from date of issuance.

Signed: _____

Improvement Permit by: Wesley Sparks RS. date 1/12/95

Existing System Inspection by: _____ date _____

Installed by: Wes Lytton

Certificate of Completion by: Wesley Sparks RS. date 4/23/95

Operation Permit by: _____ date _____

HEALTH DEPT. COPY: WHITE INSPECTION COPY (FINAL): GREEN OWNER COPY (FINAL): YELLOW INSPECTION COPY (INITIAL): PINK OWNER COPY (INITIAL): GOLD