4657585604

IREDELL COUNTY HEALTH DEPARTMENT

STATESVILLE 704-878-5305 MOORESVILLE 704-664-5281

IMPROVEMENT PERMIT / CERTIFICATE OF COMPLETION / OPERATION PERMIT / EXISTING SYSTEM INSPECTION

PROPERTY DESCRIPTION NO. 2920 DATE 1/9/95 TAX MAP NO. IM A 119 Watershed: ☐ Yes ☐ No

OWNER OR CONTRACTOR Tim Correa PHONE: Business _____ Home 545-2972

ADDRESS 5508 Bamsdale Ln. Charlotte, NC. 28227

LOCATION Rinehart Rd. (L) 150 E (L) on gravel after Kekichecs (R) fork to 3rd driveway (L)

SUBDIVISION Bobby Beasley BLOCK / SECTION _____ LOT _____ LOT AREA _____ SITE CLASS. _____ DESIGN FLOW _____ L.T.A.R. _____

Septic Tank: 1000 Gallons; STB 825 Date 6/1/95 ☑ New System ☐ Repair System Type: I, II, III, IV, V, VI

Pump Tank: _____ Gallons; PT _____ Date _____ System Description: CONV - DROP BOX

Pump Make: _____ Model _____ Serial No. 320 Repair System Description: GRAVITY PANEL

Nitrification Field: No Fields 1 Square Feet 800 Linear Feet ~~266~~ Maintenance Agreement Required: ☐ Yes ☑ No

No Lines ~~5~~ 3 Trench Width 36" Max Trench Bottom Depth 36" Gravel Depth 12"

☑ House/Mod. Home No. Bedrooms 3 ☐ Mobile Home No. Bathrooms 2 ☐ Business No. Employees _____ ☐ Other _____


☐ Slab ☑ Crawl Space ☐ Basement w/plumbing ☐ Basement wo/plumbing

Water Supply: ☑ Individual ☐ Community ☐ Public


Comments:

Comments:

INITIAL SITE SKETCH

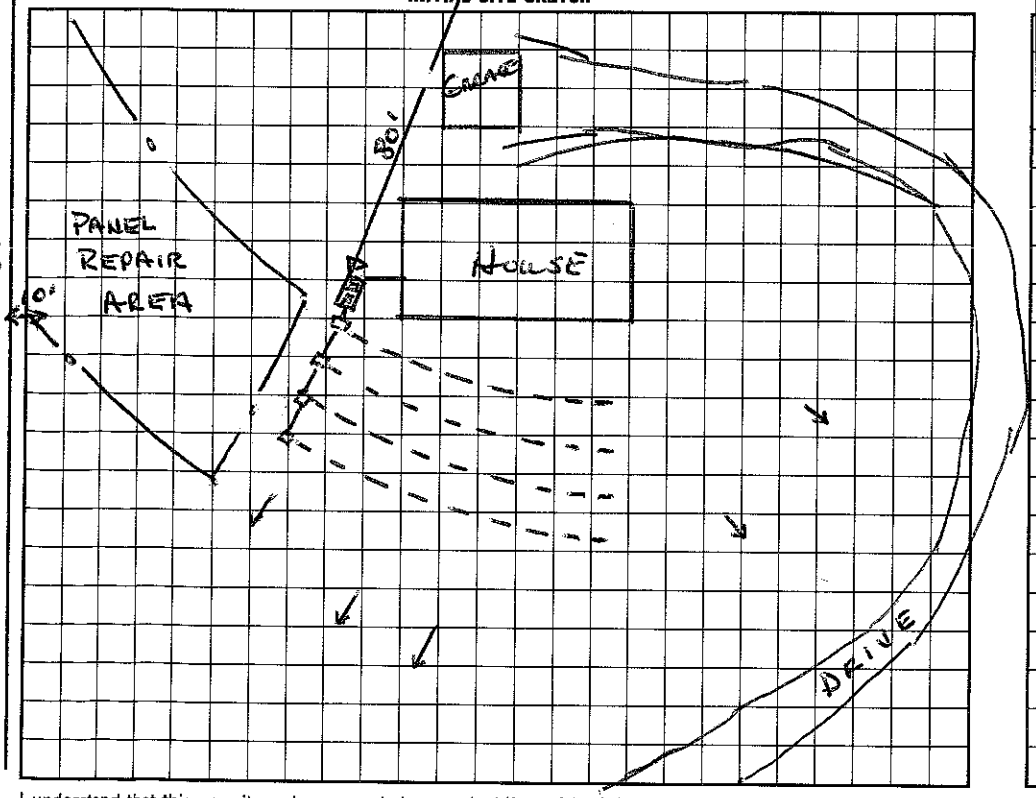

AS BUILT SKETCH

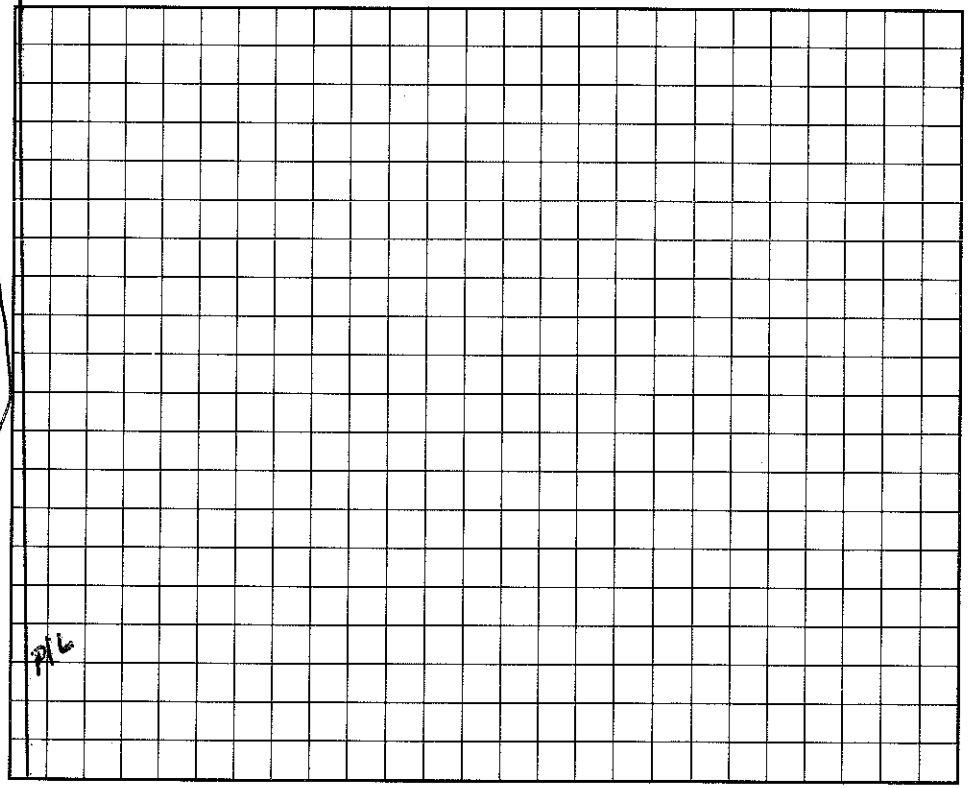

I understand that this permit can be suspended or revoked if any false information is supplied toward securing the permit/any unauthorized changes are made to the site/any unauthorized changes are made in the installation of the system. Improvement Permit is valid for 60 months from date of issuance.

Signed: R Tab Burke 1-9-95

Improvement Permit by: Wesley Sparks RS. date 1/9/95

Existing System Inspection by: _____ date _____

Installed by: Curt Dunning

Certificate of Completion by: Wesley Sparks RS date 7/19/95

Operation Permit by: _____ date _____

HEALTH DEPT. COPY: WHITE INSPECTION COPY (FINAL): GREEN OWNER COPY (FINAL): YELLOW INSPECTION COPY (INITIAL): PINK OWNER COPY (INITIAL): GOLD