4657589871

IREDELL COUNTY HEALTH DEPARTMENT

STATESVILLE 704-878-5305 MOORESVILLE 704-664-5281

IMPROVEMENT PERMIT / CERTIFICATE OF COMPLETION / OPERATION PERMIT / EXISTING SYSTEM INSPECTION

PROPERTY DESCRIPTION NO. 2703 DATE 3/16/94 TAX MAP NO. IM 16 B 12 Watershed: ☑ Yes ☐ No

OWNER OR CONTRACTOR Broadmoor Homes PHONE: Business 663-7660 Home

ADDRESS PO Box 1242 Mooresville, NC. 28115

LOCATION Sunshine Dr. off Rowhurst Rd TL to 3rd lot on R

SUBDIVISION Sunshine Estates BLOCK / SECTION 1 LOT 12 LOT AREA ≈ 1.4Ac SITE CLASS. A DESIGN FLOW 360 L.T.A.R. ≤ 3

Septic Tank: 1000 Gallons; STB 825 Date 5/1/94

Pump Tank: Gallons; PT Date

Pump Make: Model Serial No.

Nitrification Field: No Fields 1 Square Feet 1200 Linear Feet 400

No Lines 5 Trench Width 36" Max Trench Bottom Depth 30" Gravel Depth 12"

☑ New System ☐ Repair System Type: I ☑ II, III, IV, V, VI

System Description: CONV - DIST BOX

Repair System Description: SAME

Maintenance Agreement Required: ☐ Yes ☑ No

☑ House/Mod. Home No. Bedrooms 3

☐ Mobile Home No. Bathrooms 2

☐ Business No. Employees

☐ Other

☐ Slab ☑ Crawl Space ☑ Basement w/plumbing ☐ Basement wo/plumbing


Water Supply: ☑ Individual ☐ Community ☐ Public PROPOSED

Comments:

Difficult contours - P/L is need to be clearly staked before installation begun.
Trench depth 30" to trench bottom.

Comments:

INITIAL SITE SKETCH

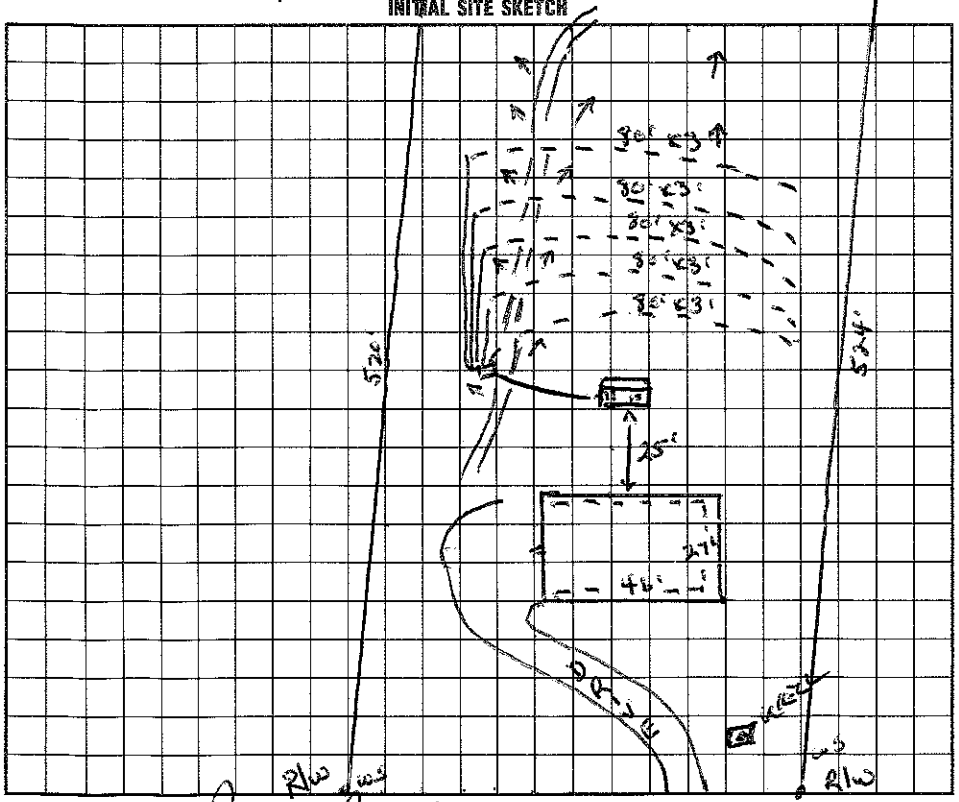

AS BUILT SKETCH

I understand that this permit can be suspended or revoked if any false information is supplied toward securing the permit/any unauthorized changes are made to the site/any unauthorized changes are made in the installation of the system. Improvement Permit is valid for 60 months from date of issuance.

Signed: Paul Broadmoor

Improvement Permit by: Wesley Sparks R.S. date 3/16/94

Existing System Inspection by: date

Installed by: Curt Dunning

Certificate of Completion by: Wesley Sparks R.S. date 6/10/94

Operation Permit by: date

HEALTH DEPT. COPY: WHITE INSPECTION COPY (FINAL): GREEN OWNER COPY (FINAL): YELLOW INSPECTION COPY (INITIAL): PINK OWNER COPY (INITIAL): GOLD