4657589974

IREDELL COUNTY HEALTH DEPARTMENT

STATESVILLE 704-878-5305 MOORESVILLE 704-664-5281

IMPROVEMENT PERMIT / CERTIFICATE OF COMPLETION / OPERATION PERMIT / EXISTING SYSTEM INSPECTION

PROPERTY DESCRIPTION NO. 2632 DATE 3/9/94 TAX MAP NO. 1M16 B 13 Watershed: ☐ Yes ☑ No

OWNER OR CONTRACTOR BROADMOOR HOMES PHONE: Business _____ Home 663-7660

ADDRESS PO BOX 1242 MOORESVILLE, NC. 28115

LOCATION SUNSHINE DR; RINEHART RD FM 150, TL KETCHIE DR, TL ON SUNSHINE, 2ND LOT ON R

SUBDIVISION SUNSHINE ESTATES BLOCK / SECTION 1 LOT 13 LOT AREA ~1.4 SITE CLASS. P DESIGN FLOW 360 L.T.A.R. .25-.3

Septic Tank: 1000 Gallons; STB 825 Date 12/8/94
Pump Tank: _____ Gallons; PT _____ Date _____
Pump Make: _____ Model _____ Serial No. _____
Nitrification Field: No Fields 1 Square Feet ~~600~~ 1200 Linear Feet 400
No Lines 4 Trench Width 3' Max Trench Bottom Depth 30-32" Gravel Depth _____

☑ New System ☐ Repair System Type: I, II, III, IV, V, VI
System Description: CONV - DROP BOXES
Repair System Description: SAME
Maintenance Agreement Required: ☐ Yes ☑ No

☑ House/Mod. Home No. Bedrooms 3
☐ Mobile Home No. Bathrooms 2
☐ Business No. Employees _____
☐ Other _____


☐ Slab ☑ Crawl Space ☐ Basement w/plumbing ☐ Basement wo/plumbing

Water Supply:
☑ Individual
☐ Community
☐ Public

Comments:

Comments:

INITIAL SITE SKETCH

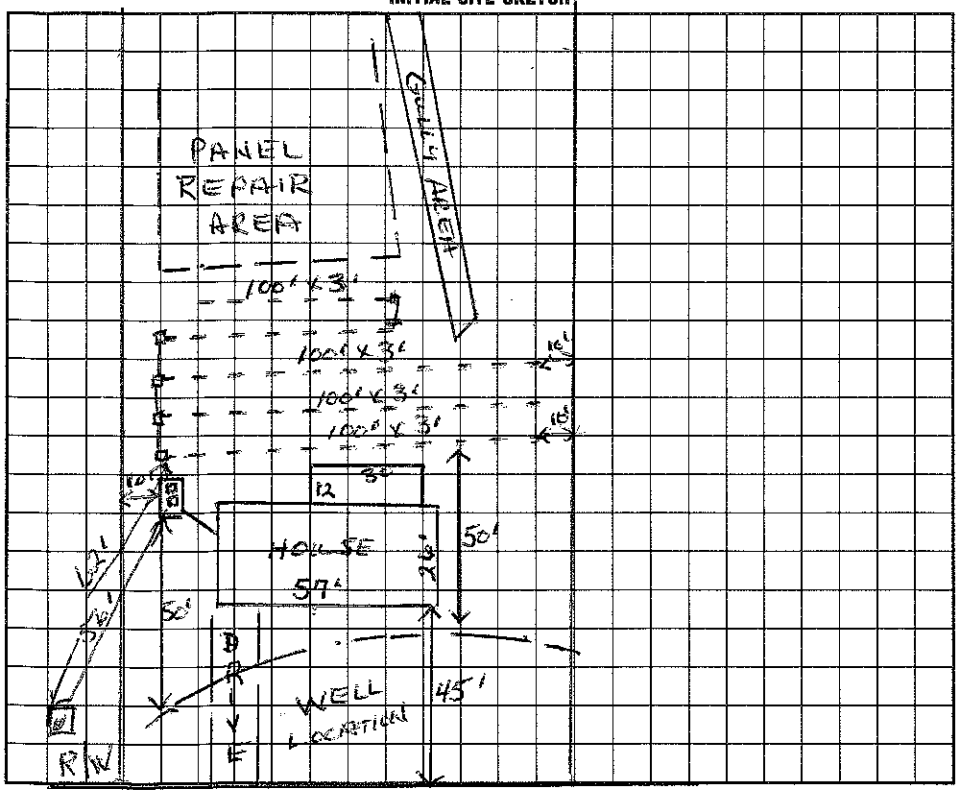

AS BUILT SKETCH

I understand that this permit can be suspended or revoked if any false information is supplied toward securing the permit/any unauthorized changes are made to the site/any unauthorized changes are made in the installation of the system. Improvement Permit is valid for 60 months from date of issuance. SUNSHINE DR.

Signed: _____

Improvement Permit by: Wesley Sparks R.S. date 3/10/94

Existing System Inspection by: Paul Woodward date _____

Installed by: Kent Dunning

Certificate of Completion by: Wesley Sparks R.S. date 1/26/95 AWS

Operation Permit by: _____ date _____

HEALTH DEPT. COPY: WHITE INSPECTION COPY (FINAL): GREEN OWNER COPY (FINAL): YELLOW INSPECTION COPY (INITIAL): PINK OWNER COPY (INITIAL): GOLD