IREDELL COUNTY HEALTH DEPARTMENT

Amended from Construct 4657598633

STATESVILLE 704-878-5305 MOORESVILLE 704-664-5281

IMPROVEMENT PERMIT / ~~CERTIFICATE OF COMPLETION~~ / OPERATION PERMIT / EXISTING SYSTEM INSPECTION

PROPERTY DESCRIPTION NO. 4456 DATE 3/14/97 TAX MAP NO. 1M16B 28-29 Watershed: [X] Yes [ ] No

OWNER OR CONTRACTOR Kenneth Duckworth PHONE: Business _____ Home 664-3631

ADDRESS 144 Marina Ln. Mooresville NC. 28115

LOCATION Rine Rent TL Ketchie Dr. TR at stop sign TL at culde-sac straight ahead

SUBDIVISION Sunshine Est. BLOCK / SECTION _____ LOT 28-29 LOT AREA 2.6 Ac SITE CLASS. PS DESIGN FLOW 360 L.T.A.R. .3

Septic Tank: 1000 Gallons; STB 794 Date 7/15/97
Pump Tank: _____ Gallons; PT _____ Date _____
Pump Make: _____ Model _____ Serial No. _____
Nitrification Field: No Fields 1 Square Feet 1200 Linear Feet 400
No Lines 3 or 4 Trench Width 36" Max Trench Bottom Depth 36" Gravel Depth 12"

[X] New System [ ] Repair System Type: I (II) III, IV, V, VI
System Description: DIST Box - CONVENTIONAL
Repair System Description: _____
Maintenance Agreement Required: [ ] Yes [ ] No


[X] House/Mod. Home No. Bedrooms 3
[ ] Mobile Home No. Bathrooms 2
[ ] Business No. Employees _____
[ ] Other _____
[ ] Slab [X] Crawl Space [ ] Basement w/plumbing [ ] Basement wo/plumbing

Water Supply: [X] Individual [ ] Community [ ] Public


Comments: Dist Box with Speed Levelers Required. Lines on slope contour

Comments:

INITIAL SITE SKETCH

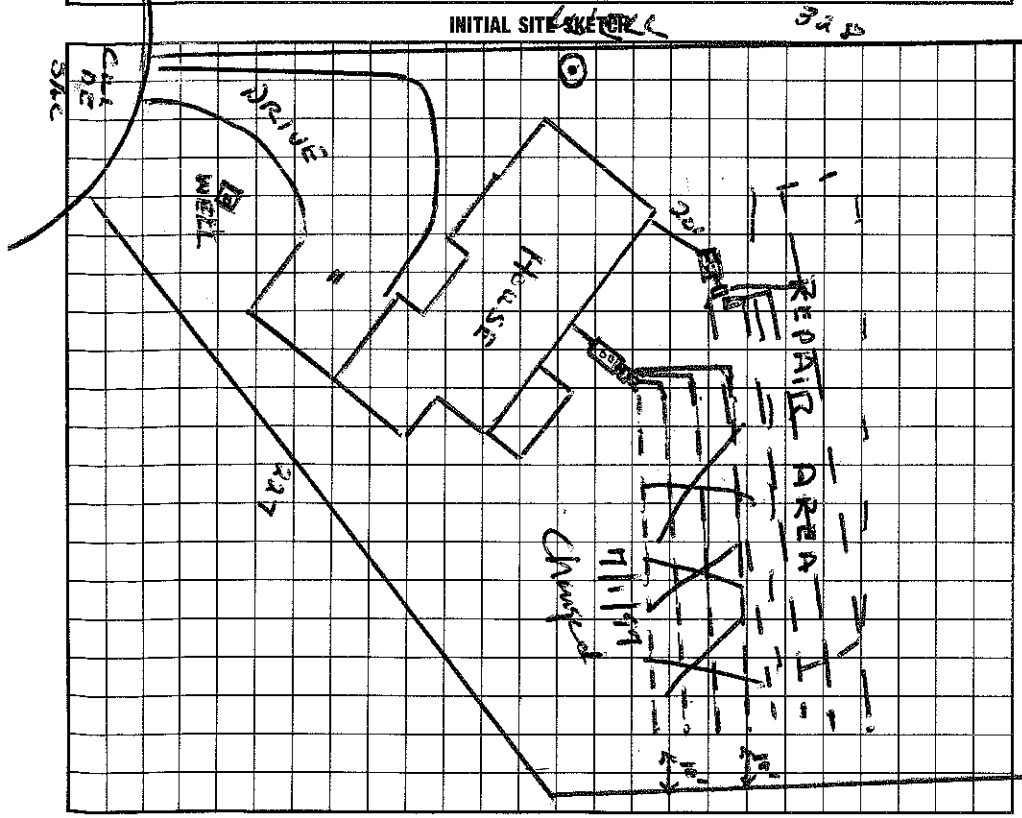

AS BUILT SKETCH

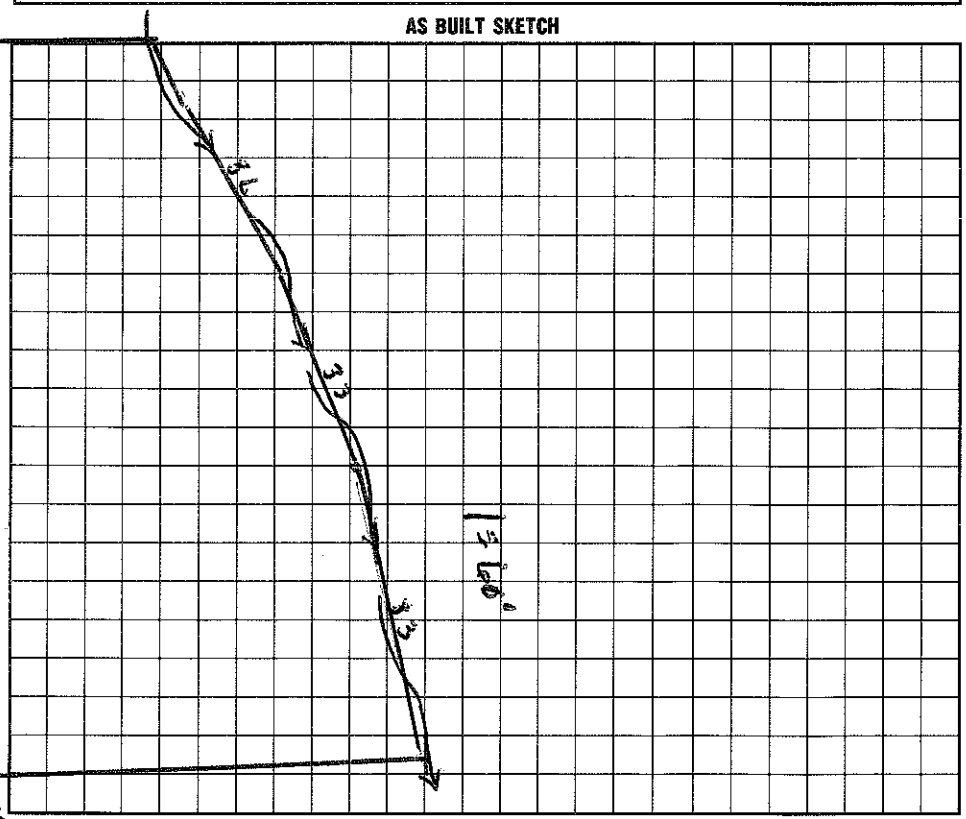

I understand that this permit can be suspended or revoked if any false information is supplied toward securing the permit/any unauthorized changes are made to the site/any unauthorized changes are made in the installation of the system. Improvement Permit is valid for 60 months from date of issuance.

Signed: Kenneth R. Duckworth

Improvement Permit by: Wesley Sparks RS. date 3/14/97

~~Existing System Inspection by:~~ Wesley Sparks RS. date 3/14/97

Installed by: Julian Bowles

Certificate of Completion by: Wesley Sparks RS date 10/24/97

Operation Permit by: Wesley Sparks RS date 10/24/97

HEALTH DEPT. COPY: WHITE INSPECTION COPY (FINAL): GREEN OWNER COPY (FINAL): YELLOW INSPECTION COPY (INITIAL): PINK OWNER COPY (INITIAL): GOLD