IREDELL COUNTY HEALTH DEPARTMENT

STATESVILLE 704-878-5305 MOORESVILLE 704-664-5281

IMPROVEMENT PERMIT / CERTIFICATE OF COMPLETION / OPERATION PERMIT / EXISTING SYSTEM INSPECTION

PROPERTY DESCRIPTION NO. 2735 DATE 4/11/94 TAX MAP NO. 1M16B-15 Watershed: ☑ Yes ☐ No

OWNER OR CONTRACTOR Broadmoor Homes PHONE: Business 663-7660 Home

ADDRESS PO Box 1242 Mooresville, NC. 28115

LOCATION Sunshine Dr.

SUBDIVISION Sunshine Estates BLOCK / SECTION LOT 15 LOT AREA ~1.12AC SITE CLASS. P DESIGN FLOW 360 L.T.A.R. .25-.3

Septic Tank: 1000 Gallons; STB 825 Date 5-4-94

Pump Tank: Gallons; PT Date

Pump Make: Model Serial No.

Nitrification Field: No Fields 1 Square Feet 1200 Linear Feet 400

No Lines 5 Trench Width 3' Max Trench Bottom Depth 30" Gravel Depth 12"

☑ New System ☐ Repair System Type: I, ☑ II, III, IV, V, VI

System Description: CONV - DIST. BOX

Repair System Description: SAME

Maintenance Agreement Required: ☐ Yes ☑ No

☑ House/Mod. Home No. Bedrooms 3

☐ Mobile Home No. Bathrooms 2

☐ Business No. Employees

☐ Other


☐ Slab ☑ Crawl Space ☐ Basement w/plumbing ☐ Basement wo/plumbing

Water Supply: ☑ Individual ☐ Community ☐ Public


Comments:

Comments: Tank seal - tank outlet - tank knockout - d.box outlet seals - all OK. Advised installer to maintain 9' separation center-to center throughout length of ditch - Depth 24" to 32"

INITIAL SITE SKETCH

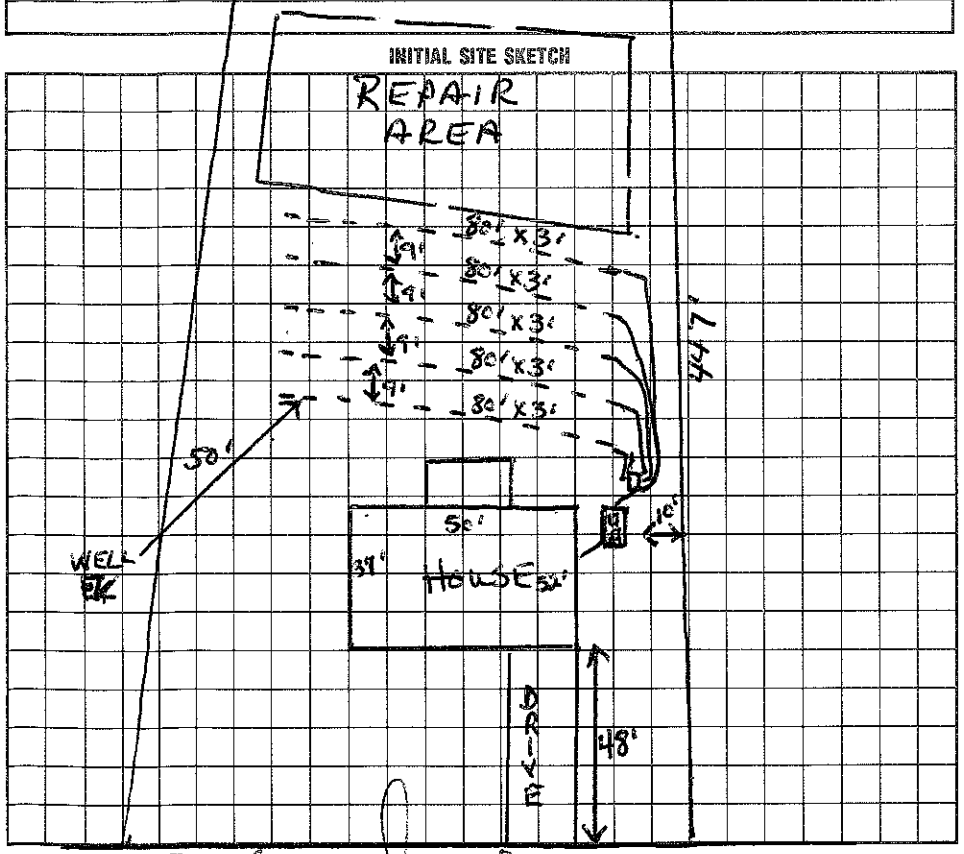

AS BUILT SKETCH

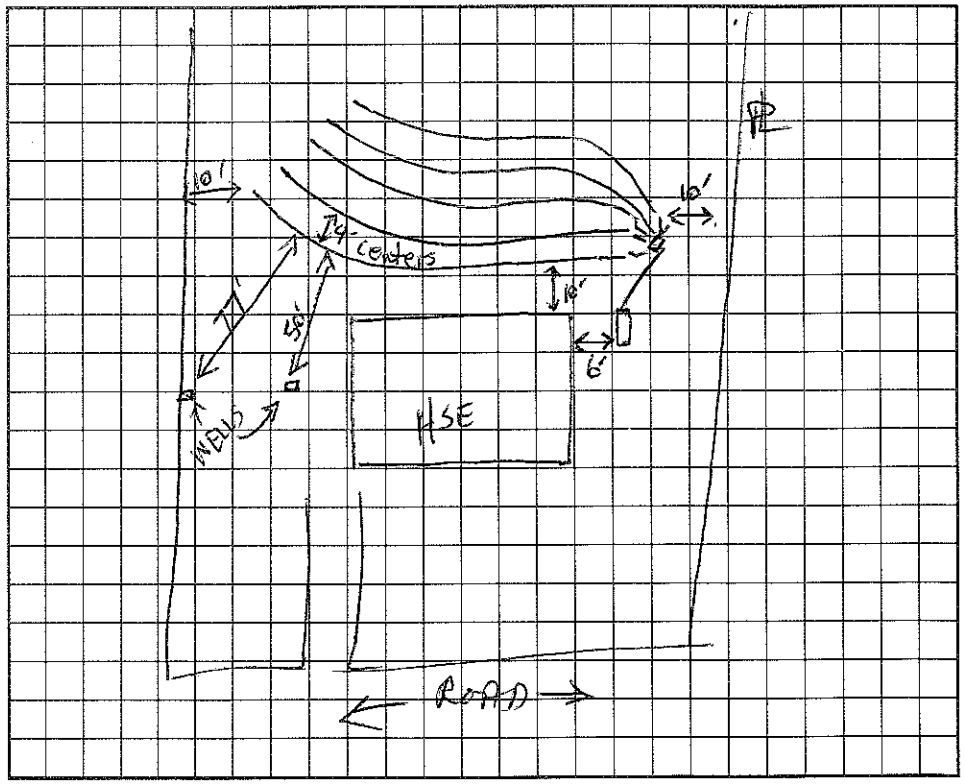

I understand that this permit can be suspended or revoked if any false information is supplied toward securing the permit/any unauthorized changes are made to the site/any unauthorized changes are made in the installation of the system. Improvement Permit is valid for 60 months from date of issuance. SUNSHINE DR.

Signed:

Improvement Permit by: Wesley Sparks R.S. date 4/11/94

Existing System Inspection by: date

Installed by: CURT DUNNING

Certificate of Completion by: Andrea Lemon date 8-2-94

Operation Permit by: date

HEALTH DEPT. COPY: WHITE INSPECTION COPY (FINAL): GREEN OWNER COPY (FINAL): YELLOW INSPECTION COPY (INITIAL): PINK OWNER COPY (INITIAL): GOLD