IREDELL COUNTY HEALTH DEPARTMENT

STATESVILLE 704-878-5305 MOORESVILLE 704-664-5281

IMPROVEMENT PERMIT / AUTHORIZATION TO CONSTRUCT / OPERATION PERMIT / EXISTING SYSTEM INSPECTIO

PERMIT# 6303-MOORESVILLE PIN# 4657599168 DATE 3/18/99

OWNER OR CONTRACTOR ED WISE PHONE: Business Home 664-8513

ADDRESS 134 SUNSHINE DR.

LOCATION 150 - TR RHINEHART - TL KETCHIE - TR SUNSHINE ON LT

SUBDIVISION SUNSHINE EST BLOCK / SECTION LOT 15 LOT AREA 1.2 AC SITE CLASS. PS DESIGN FLOW 360 L.T.A.R. .3

Septic Tank: EXISTING Gallons; STB Date

Pump Tank: Gallons; PT Date

Pump Make: Model Serial No.

Nitrification Field: No Fields 1 Square Feet ADD - 480 Linear Feet ADD 160

No Lines ADD 2@80' Trench Width 36" Max Trench Bottom Depth 36" Gravel Depth 12"

☑ New System ☐ Repair System Type: I, II, III, IV, V, VI

System Description: GRAVITY ~~CHAMBER~~ CONVENTIONAL

Repair System Description:

Maintenance Agreement Required: ☐ Yes ☑ No

☑ House/Mod. Home No. Bedrooms 3

☐ Mobile Home No. Bathrooms 2

☐ Business No. Employees

☐ Other

☐ Slab ☑ Crawl Space ☐ Basement w/plumbing ☐ Basement wo/plumbing


Water Supply: ☑ Individual ☐ Public ☐ Community

Comments:/Conditions: TOTAL OF 1200 ft² - 400 linear ft

Comments:/Conditions:

Installed as shown -

INITIAL SITE SKETCH

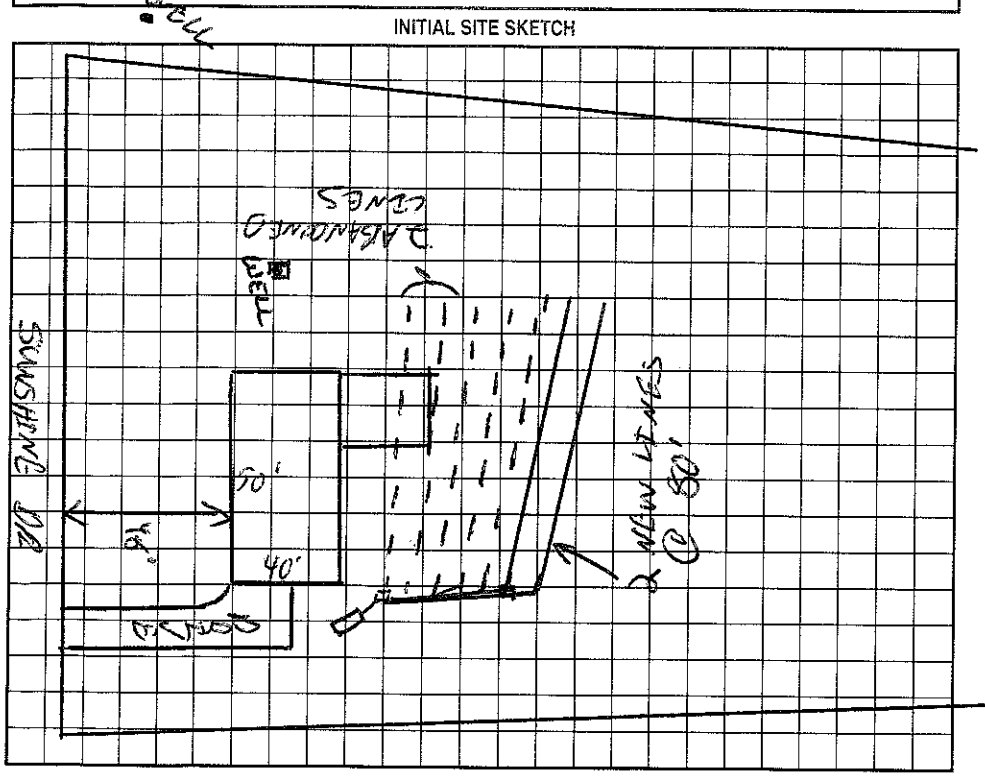

AS BUILT SKETCH

Permit can be suspended or revoked if any false information is supplied toward securing the permit/any unauthorized changes are made to the site/any unauthorized changes are made in the installation of the system. Improvement Permit with plat valid without expiration. Improvement Permit with site plan valid for sixty months. Authorization to Construct is valid for a period equal to that of Improvement Permit – not to exceed sixty months.

Signed: Susan A Ulyse date 3/19/99

Improvement Permit by: RS date 3/18/99

Authorization to Construct by: RS date 3/18/99

Installed by: Levon Benton

Operation Permit by: Wesley Sparks RS date 5/5/99

Existing System Inspection by: date

HEALTH DEPT. COPY: WHITE OWNER COPY (FINAL): YELLOW OWNER COPY (INITIAL): PINK