2130-3100

IREDELL COUNTY HEALTH DEPARTMENT

ATESVILLE 704-878-5305 MOORESVILLE 704-664-5281

IMPROVEMENT PERMIT / AUTHORIZATION TO CONSTRUCT / OPERATION PERMIT / EXISTING SYSTEM INSPECTION

PERMIT# Repair PIN# 4057645948 DATE 5/8/98

OWNER OR CONTRACTOR Ruby Rinehardt PHONE: Business Home 664-5530

ADDRESS 528 Rinehardt Rd Mooresville NC

LOCATION 150 E TL Rhinehardt Rd 1st house on left - 528 Rinehardt (Red Brick Hse)

SUBDIVISION BLOCK / SECTION LOT LOT AREA Acreage SITE CLASS. PS DESIGN FLOW 360 L.T.A.R. .275-.3

Septic Tank: Existing Gallons; STB Date

Pump Tank: Gallons; PT Date

Pump Make: Model Serial No.

Nitrification Field: No Fields 1 Square Feet Linear Feet 200'

No Lines 2 at 100' Trench Width 36" Max Trench Bottom Depth 33" Gravel Depth 12"

☐ New System ☒ Repair System Type: I, (II), III, IV, V, VI

System Description: Grav. - Conventional

Repair System Description:

Maintenance Agreement Required: ☐ Yes ☐ No

☒ House/Mod. Home No. Bedrooms 3

☐ Mobile Home No. Bathrooms

☐ Business No. Employees

☐ Other


☐ Slab ☐ Crawl Space ☐ Basement w/plumbing ☒ Basement wo/plumbing

Water Supply: ☒ Individual ☐ Public ☐ Community

Comments:/Conditions: Installer can use D-Box, Drop Box or Flow Divider for Distribution (Septic System in Pasture)

Comments:/Conditions: System originally installed in 60's

INITIAL SITE SKETCH Not to Scale

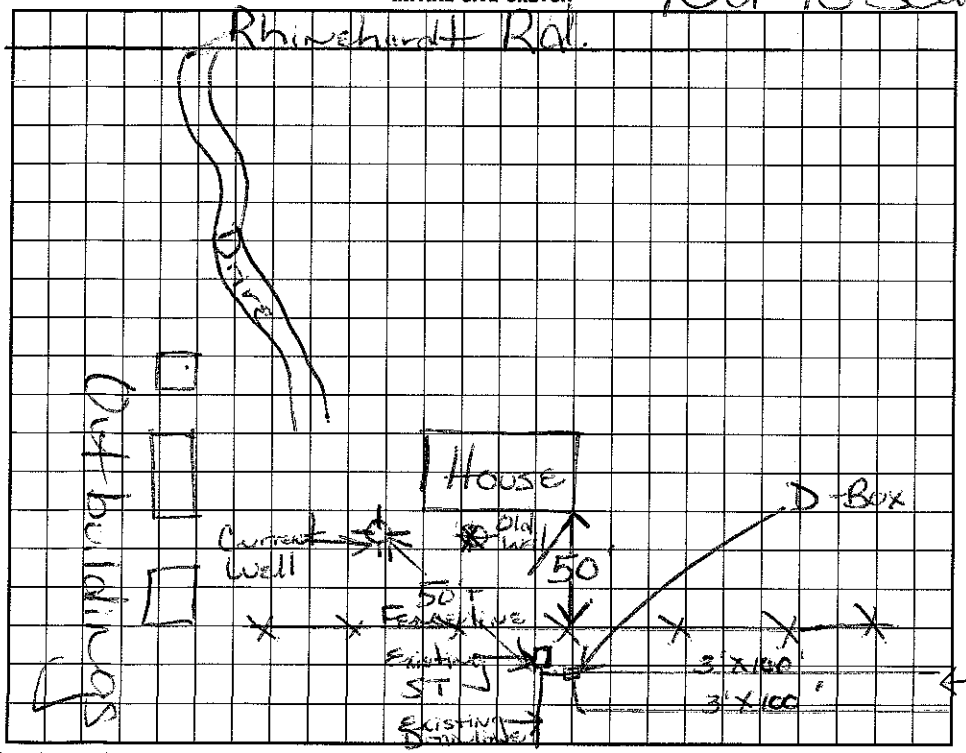

AS BUILT SKETCH

I understand that this permit can be suspended or revoked if any false information is supplied toward securing the permit/any unauthorized changes are made to the site/any unauthorized changes are made in the installation of the system. Improvement Permit with plat valid without expiration. Improvement Permit with site plan valid for sixty months. Authorization to Construct is valid for a period equal to that of Improvement Permit – not to exceed sixty months.

Signed: Ruby Rinehardt date

Improvement Permit by: Marian H. Dobson date 5/8/98

Authorization to Construct by: Marian H. Dobson date 5/8/98

Installed by: JULIAN BOWLES

Operation Permit by: C. Bailey Jr. date 5/29/98

Existing System Inspection by: date

HEALTH DEPT. COPY: WHITE INSPECTION COPY (FINAL): GREEN OWNER COPY (FINAL): YELLOW INSPECTION COPY (INITIAL): PINK OWNER COPY (INITIAL): GOLD