4657684340

IREDELL COUNTY HEALTH DEPARTMENT

STATESVILLE 704-878-5305 MOORESVILLE 704-664-5281

IMPROVEMENT PERMIT / CERTIFICATE OF COMPLETION / OPERATION PERMIT / EXISTING SYSTEM INSPECTION

PROPERTY DESCRIPTION NO. 25485 DATE 12/2/93 TAX MAP NO. 1M16A 20 Watershed: ☐ Yes ☐ No

OWNER OR CONTRACTOR BROADMOOR HOMES PHONE: Business 663-7660 Home

ADDRESS PO Box 1242 Mooresville NC 28115

LOCATION N on SR 1306 FROM hwy 150, approx. 1 mile on W/S First private road in Ketchie acres Sbdvn, at end of loft fork

SUBDIVISION SUNSHINE ESTATES BLOCK / SECTION — LOT 6 LOT AREA 1.2455 SITE CLASS. P DESIGN FLOW 360 L.T.A.R. 0.25-0.3

Septic Tank: 1000 Gallons; STB 825 Date 11/4/94 ☒ New System ☐ Repair System Type: I, II, III, IV, V, VI ☒ House/Mod. Home No. Bedrooms 3

Pump Tank: NA Gallons; PT — Date — System Description: gravity conventional ☐ Mobile Home No. Bathrooms 2

Pump Make: NA Model — Serial No. — Repair System Description: gravity conventional ☐ Business No. Employees —

Nitrification Field: No Fields 1 Square Feet 1200 MIN. Linear Feet 400 MIN. Maintenance Agreement Required: ☐ Yes ☒ No ☐ Other

No Lines 2 OR 3 Trench Width 36" Max Trench Bottom Depth 20-24" Gravel Depth 12" ☐ Slab ☒ Crawl Space ☐ Basement w/plumbing ☐ Basement wo/plumbing


Water Supply: ☒ Individual ☐ Community ☐ Public

Comments: DO NOT INSTALL DURING WET SOIL CONDITIONS OR RAIN. ELEVATION OF FOUNDATION AND OF PLUMBING STUBOUT MUST BE SET TO ACCOMODATE AN ABOVE GRADE SEPTIC TANK-BLDG CONTRACTOR MUST MEET W DEPT. REP. ON SITE TO DETERMINE THIS OR AN EFFLUENT PUMP COULD BE REQUIRED.

Comments:

INITIAL SITE SKETCH

10' SETBACK W/SYSTEM TO UPSLOPE INTERCEPTER DRAIN. REGRADE DRAIN AT REAR OF LOT TO FACILITATE OUTLET.

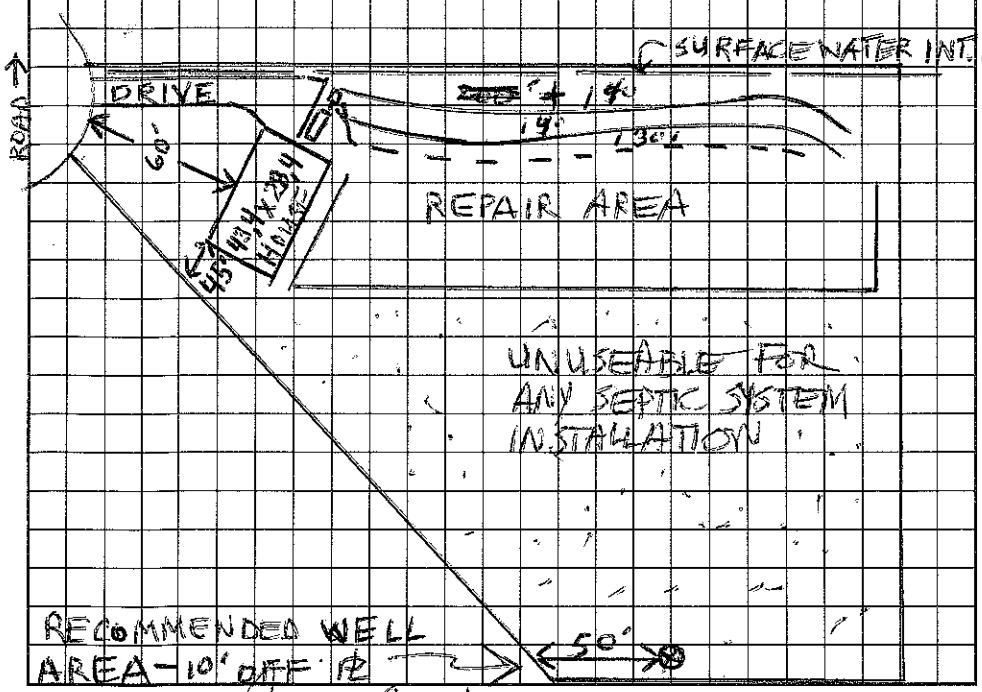

AS BUILT SKETCH

I understand that this permit can be suspended or revoked if any false information is supplied toward securing the permit/any unauthorized changes are made to the site/any unauthorized changes are made in the installation of the system. Improvement Permit is valid for 60 months from date of issuance.

Signed: Paul Woodruff

Improvement Permit by: Andrea Lemon, RS date 12/2/93

Existing System Inspection by: — date —

Installed by: Curt Dunning

Certificate of Completion by: Wally Sparkes date 3/1/94

Operation Permit by: — date —

HEALTH DEPT. COPY: WHITE INSPECTION COPY (FINAL): GREEN OWNER COPY (FINAL): YELLOW INSPECTION COPY (INITIAL): PINK OWNER COPY (INITIAL): GOLD