4657684428

IREDELL COUNTY HEALTH DEPARTMENT

STATESVILLE 704-878-5305 MOORESVILLE 704-664-5281

IMPROVEMENT PERMIT / CERTIFICATE OF COMPLETION / OPERATION PERMIT / EXISTING SYSTEM INSPECTION

PROPERTY DESCRIPTION NO. 2767 DATE 5/4/94 TAX MAP NO. IM 16 B 5 Watershed: ☐ Yes ☒ No

OWNER OR CONTRACTOR Broadmoor Homes PHONE: Business 663-7660 Home

ADDRESS PO Box 1242 Mooresville, NC. 28115

LOCATION SUNSHINE DR; 1ST (L) ON RINEHART (L) KETCHIE (L) ON SUNSHINE TO 4th LOT ON (L)

SUBDIVISION SUNSHINE EST. BLOCK / SECTION 1 LOT 5 LOT AREA 1.015 AC SITE CLASS. A DESIGN FLOW 360 L.T.A.R. .25-.3

Septic Tank: 1000 Gallons; STB 825 Date 10/4/94
Pump Tank: Gallons; PT Date
Pump Make: Model Serial No.
Nitrification Field: No Fields 1 Square Feet 1200 Linear Feet 400
No Lines 4 Trench Width 3' Max Trench Bottom Depth 32" Gravel Depth

☑ New System ☐ Repair System Type: I (II) III, IV, V, VI
System Description: CONV - DROP BOXES
Repair System Description: SAME
Maintenance Agreement Required: ☐ Yes ☒ No


☑ House/Mod. Home No. Bedrooms 3
☐ Mobile Home No. Bathrooms 2
☐ Business No. Employees
☐ Other
☐ Slab ☒ Crawl Space ☐ Basement w/plumbing ☐ Basement wo/plumbing

Water Supply:
☑ Individual
☐ Community
☐ Public


Comments: ON CONTOUR IN DIRECTION SITUATION.

Comments:

INITIAL SITE SKETCH

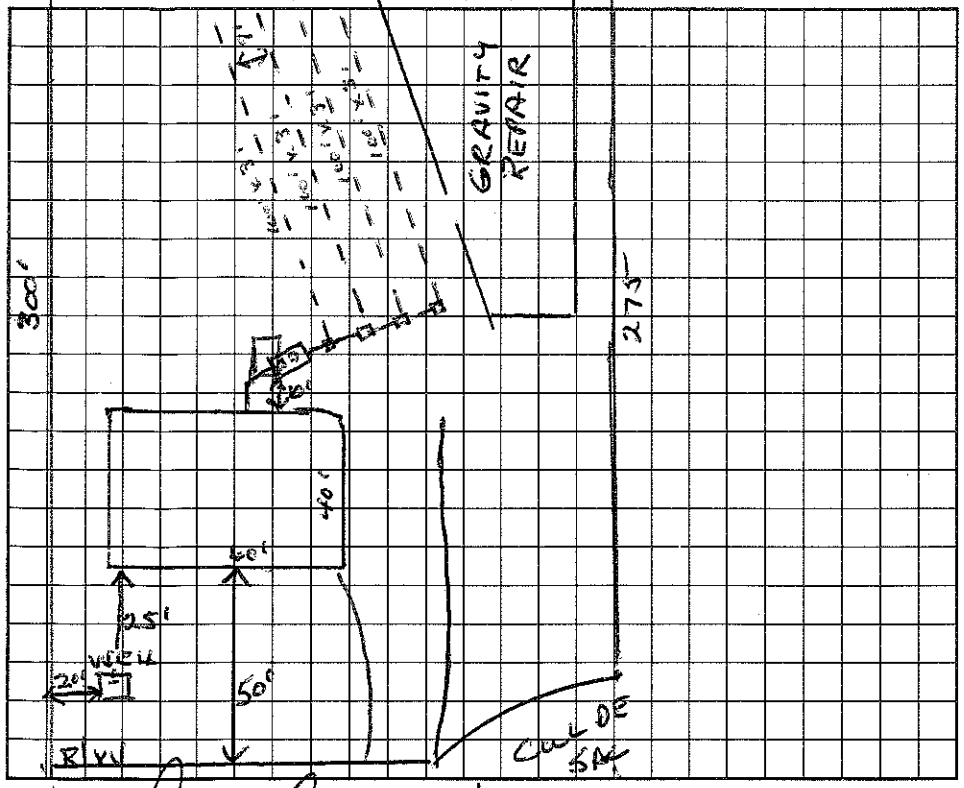

AS BUILT SKETCH

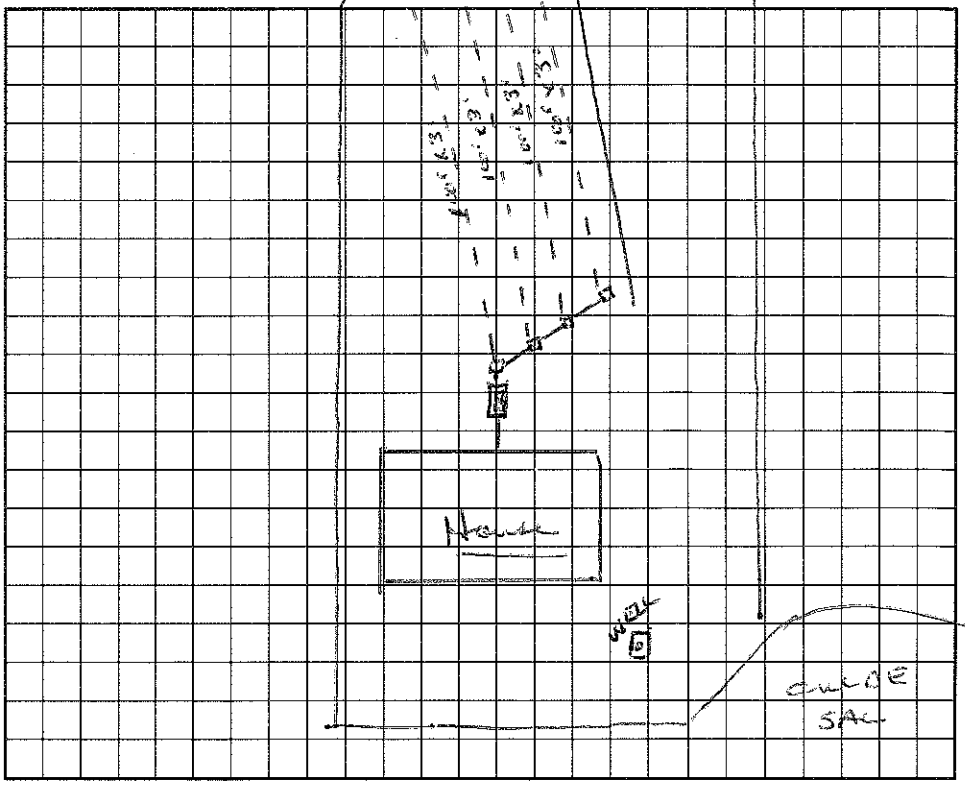

I understand that this permit can be suspended or revoked if any false information is supplied toward securing the permit/any unauthorized changes are made to the site/any unauthorized changes are made in the installation of the system. Improvement Permit is valid for 60 months from date of issuance.

Signed: David Broadhurst

Improvement Permit by: Wesley Sparks RS. date 5/4/94

Existing System Inspection by: date

Installed by: Curt Dunning

Certificate of Completion by: Wesley Sparks RS. date 12/14/9

Operation Permit by: date

HEALTH DEPT. COPY: WHITE INSPECTION COPY (FINAL): GREEN OWNER COPY (FINAL): YELLOW INSPECTION COPY (INITIAL): PINK OWNER COPY (INITIAL): GOLD