IREDELL COUNTY HEALTH DEPARTMENT

STATESVILLE 704-878-5305 MOORESVILLE 704-664-5281

IMPROVEMENT PERMIT / AUTHORIZATION TO CONSTRUCT / OPERATION PERMIT / EXISTING SYSTEM INSPECTION

PERMIT # 157983 PIN # 4657 69 2439 DATE 8/17/09

OWNER or APPLICANT RYAN MOORE PHONE: Business 704-746-5879 Home: ~~704-593-6444~~ 704-592-2015

OWNER or APPLICANT ADDRESS 127 SUNSHINE DR. MOORESVILLE, NC. 28115

LOCATION / DIRECTIONS I-77 E TL RAINEHARDT RD. TL SUNSHINE, LOT ON (L)

SUBDIVISION SUNSHINE ESTATES BLOCK / SECTION LOT # 18 LOT AREA .978 DESIGN FLOW 360 L.T.A.R. .3

Septic Tank 1600 Gallons: STB Date

Pump Tank 1000 Gallons: PT Date

Pump Make Model Serial #

Nitrification Field No Fields No Lines 3 Linear Feet 210

Trench Width 2-3 Max. Trench Bottom Depth 3' Gravel Depth No

☐ New System ☐ Repair ☐ Expansion System Type I II III (IV) V VI

System Description: LP - 16A APBPS

Repair System Description: SAME TYPE

Maintenance Agreement Required ☒ YES ☐ NO

☐ GRAVITY ☒ PRESSURE

☒ Residence No. Bedrooms 3 ☐ Business No. Persons ☐ Other No. Employees ☐ Slab ☐ Crawl Space ☒ Basement w/plumbing ☐ Basement w/o plumbing


Water Supply ☒ Private ☐ Public ☐ Community

Comments / Conditions

PWR R/W

Comments / Conditions

INITIAL SITE SKETCH

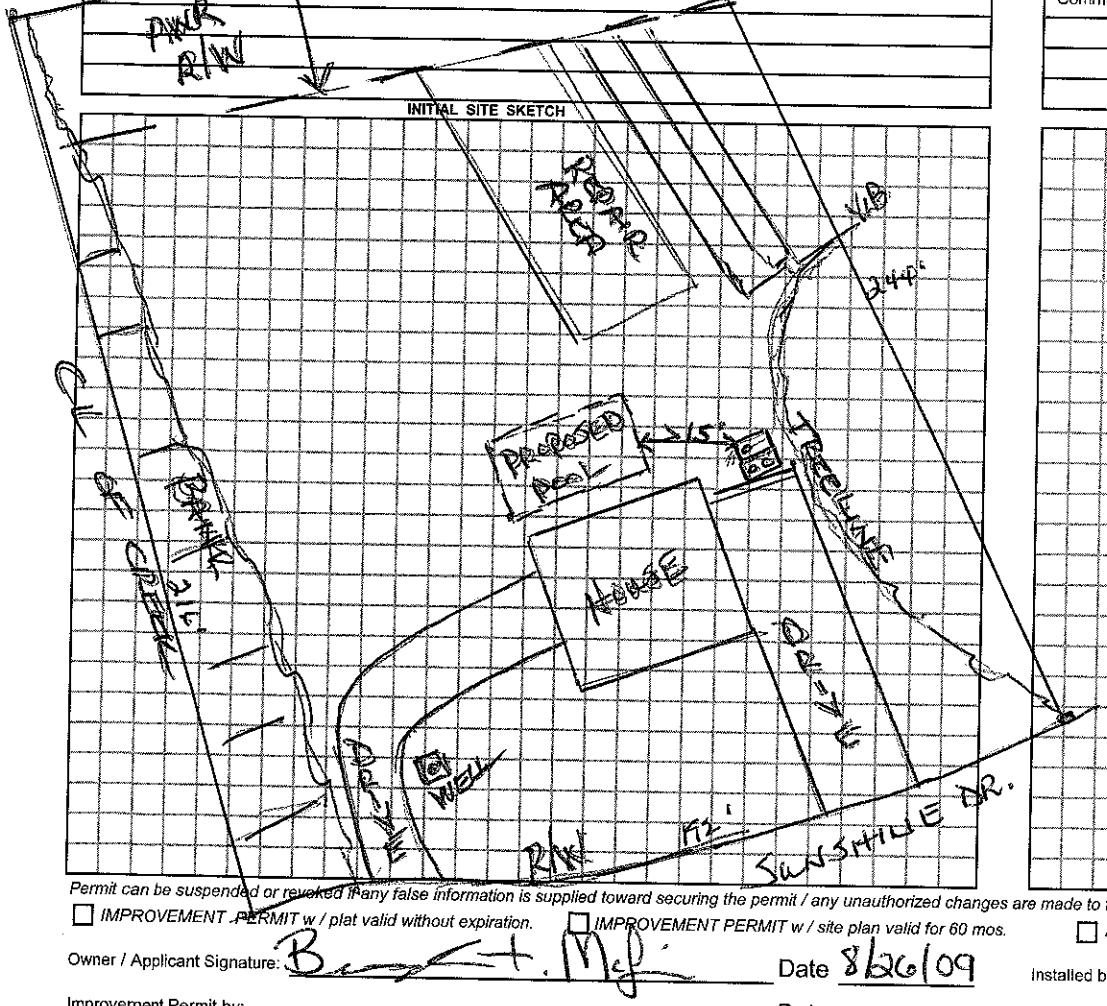

AS BUILT SKETCH

Permit can be suspended or revoked if any false information is supplied toward securing the permit / any unauthorized changes are made to the site / any unauthorized changes are made in the installation of the system.

☐ *IMPROVEMENT PERMIT w / plat valid without expiration.* ☐ *IMPROVEMENT PERMIT w / site plan valid for 60 mos.* ☐ *AUTHORIZATION TO CONSTRUCT valid for period equal to IMPROVEMENT PERMIT-not to exceed 60 mo.*

Owner / Applicant Signature: Bryant L. McLain Date 8/26/09

Improvement Permit by: Date

Authorization to Construct by: Date

YOU SHOULD CONTACT A LOCATOR SERVICE PRIOR TO ANY EXCAVATION.

Installed by: L. Beam

Operation Permit by: W Sparks RS. Date: 10/31/09

Existing System Inspected by: Wesley Sparks RS Date: 8/17/09

WHITE COPY Environmental Health YELLOW COPY (Final) Owner / Applicant PINK COPY (Initial) Owner / Applicant