IREDELL COUNTY HEALTH DEPARTMENT

4657692721

STATESVILLE 704-878-5305 MOORESVILLE 704-664-5281

IMPROVEMENT PERMIT / CERTIFICATE OF COMPLETION / OPERATION PERMIT / EXISTING SYSTEM INSPECTION

PROPERTY DESCRIPTION NO. 2425 DATE 8/17/93 TAX MAP NO. 1M 16 B 30

OWNER OR CONTRACTOR BROAD MOOR HOMES PHONE: Business 663-7660 Home

ADDRESS PO BOX 1242 MOORESVILLE, NC. 28115

LOCATION SUNSHINE DR, RINEHART RD TL FIRST KETCHIE TO INT. TR X CREEK LOT ON (R) CORNER

SUBDIVISION SUNSHINE EST BLOCK / SECTION LOT 30 LOT AREA ~1AC SITE CLASS. P L.T.A.R. .25-.3

Water Supply: ☐ Individual ☐ Community ☐ Public 825 RST 8-2-93

Septic Tank: 1000 Gallons; STB ~~825~~ Date ~~8-2-93~~

Pump Tank: ~~1000~~ Gallons; PT 2 Date ~~8-17-93~~

Nitrification Field: No Fields 1 Square Feet 1260 Linear Feet 420

No Lines 6 Trench Width 3' Trench Depth 28" Gravel Depth 12"

☑ New System ☐ Repair System Type: I, (II), III, IV, V, VI

System Description: CONV

Repair System Description: CONV

Maintenance Agreement Required: ☐ Yes ☑ ~~No~~

☑ House/Mod. Home No. Bedrooms 3 Garbage Disposal: ☐ Yes ☑ ~~No~~

☐ Mobile Home No. Bathrooms 2 Auto. Dishwasher: ☑ Yes ☐ No


☐ Business No. Employees Auto. Washing Machine: ☑ ~~Yes~~ ☐ No

☐ Other Other


☐ Slab ☑ Crawl Space ☐ Basement w/plumbing ☐ Basement wo/plumbing

Comments MAX TRENCH DEPTH 28" - DROP BOXES IN DESIGN SHOWN HERE

INITIAL SITE SKETCH

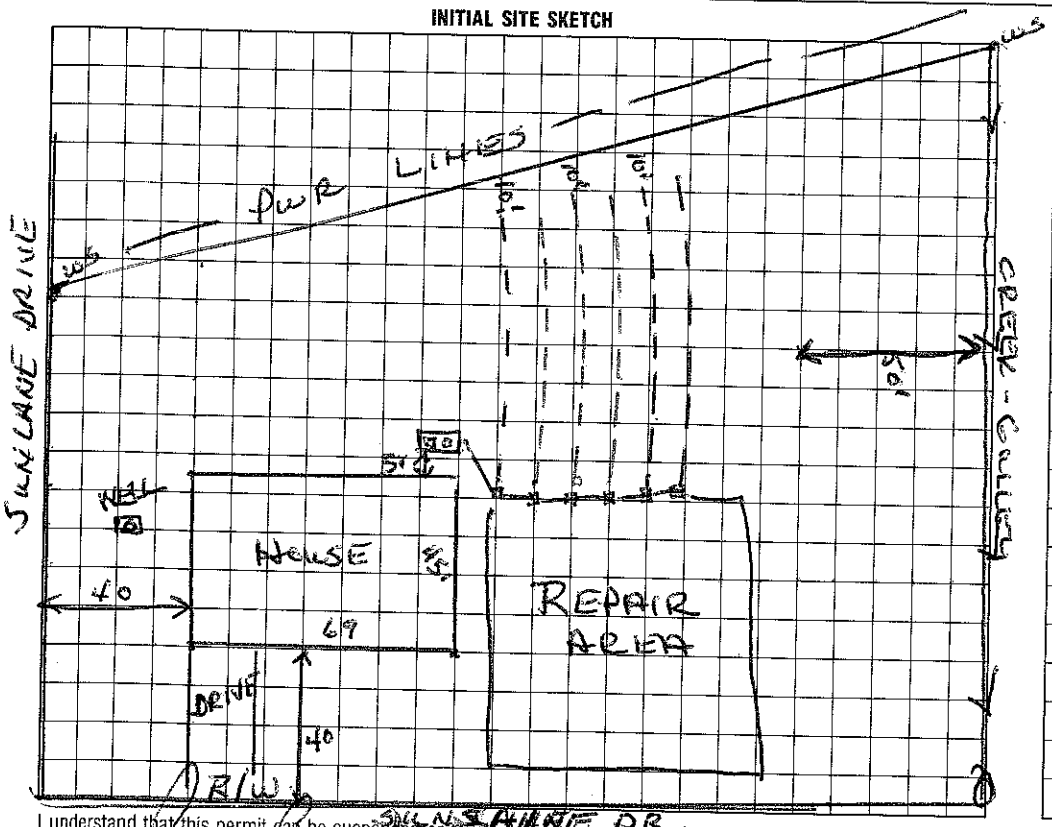

AS BUILT SKETCH

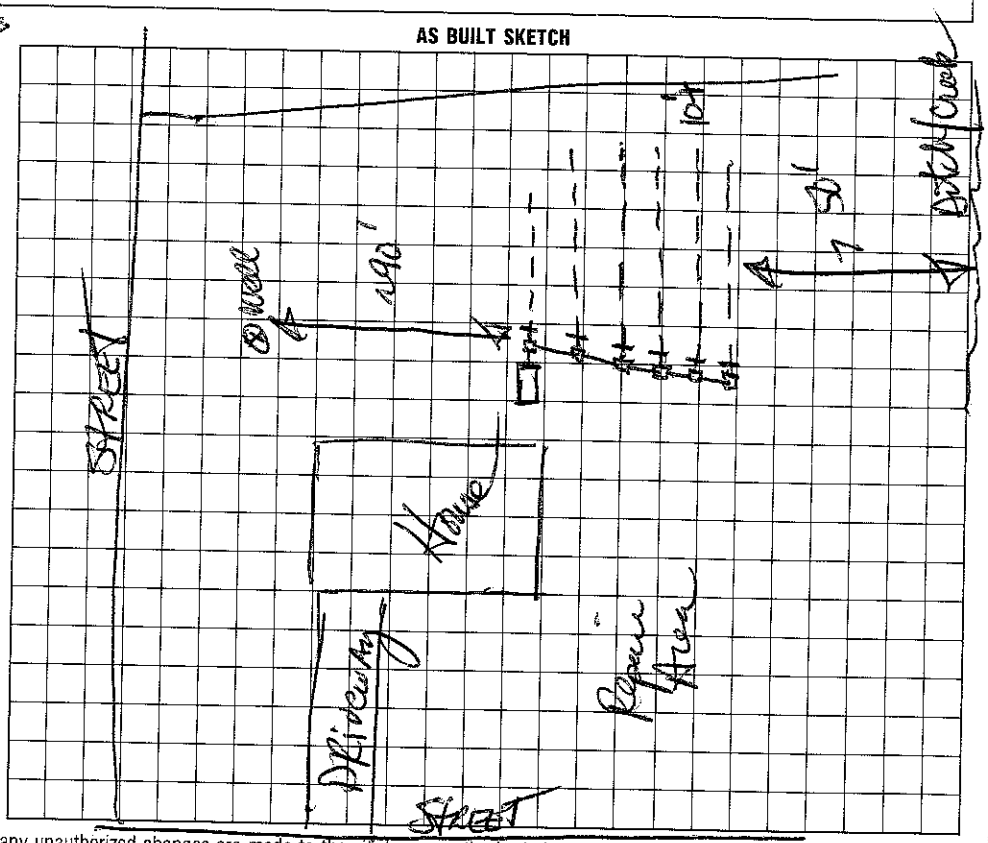

I understand that this permit can be suspended or revoked if any false information is supplied toward securing the permit/any unauthorized changes are made to the site/any unauthorized changes are made in the installation of the system. Improvement Permit is valid for 60 months from date of issuance.

Signed:

Improvement Permit by: Wesley Sparks RS. date 8/17/93

Existing System Inspection by: date

Installed by: Curt Dunmore

Certificate of Completion by: date 10/8/93

Operation Permit by: date

HEALTH DEPT. COPY: WHITE INSPECTION COPY (FINAL): GREEN OWNER COPY (FINAL): YELLOW INSPECTION COPY (INITIAL): PINK OWNER COPY (INITIAL): GOLD