4657693096

IREDELL COUNTY HEALTH DEPARTMENT

STATESVILLE 704-878-5305 MOORESVILLE 704-664-5281

IMPROVEMENT PERMIT / CERTIFICATE OF COMPLETION / OPERATION PERMIT / EXISTING SYSTEM INSPECTION

PROPERTY DESCRIPTION NO. 2164 DATE 6/24/93 TAX MAP NO. 1M 16 B1

OWNER OR CONTRACTOR BROADMOOR HOMES PHONE: Business 663-7660 Home

ADDRESS SUNSHINE DR KETCHIE

LOCATION RINEHART RD TL ON ~~SUNSHINE~~ TL ON SUNSHINE, FIRST DRIVE ON (L)

SUBDIVISION SUNSHINE BLOCK / SECTION 1 LOT 1 LOT AREA .71 SITE CLASS. P L.T.A.R. .25-.3

Water Supply: ☐ Individual ☐ Community ☐ Public

Septic Tank: 1000 Gallons; STB 825 Date 4/28/93

Pump Tank: _____ Gallons; PT _____ Date _____

Nitrification Field: No Fields 1 Square Feet 1200 Linear Feet 400

No Lines 4 Trench Width 36" Trench Depth 30" Gravel Depth 12"

☑ New System ☐ Repair System Type: I, II, III, IV, V, VI

System Description: CONV.

Repair System Description: CONV.

Maintenance Agreement Required: ☐ Yes ☐ No

☑ House/Mod. Home No. Bedrooms 3

☐ Mobile Home No. Bathrooms 2

☐ Business No. Employees _____

☐ Other _____

☐ Slab ☑ Crawl Space ☐ Basement w/plumbing ☐ Basement wo/plumbing

Garbage Disposal: ☐ Yes ☐ ~~No~~

Auto. Dishwasher: ☑ Yes ☐ No

Auto. Washing Machine: ☑ Yes ☐ No

Other _____


Comments

TRENCHES 1 & 2 REWORKED TO IMPROVE GRADE

STEPDOWN IN 1 LINE

INITIAL SITE SKETCH

AS BUILT SKETCH SUNSHINE DR.

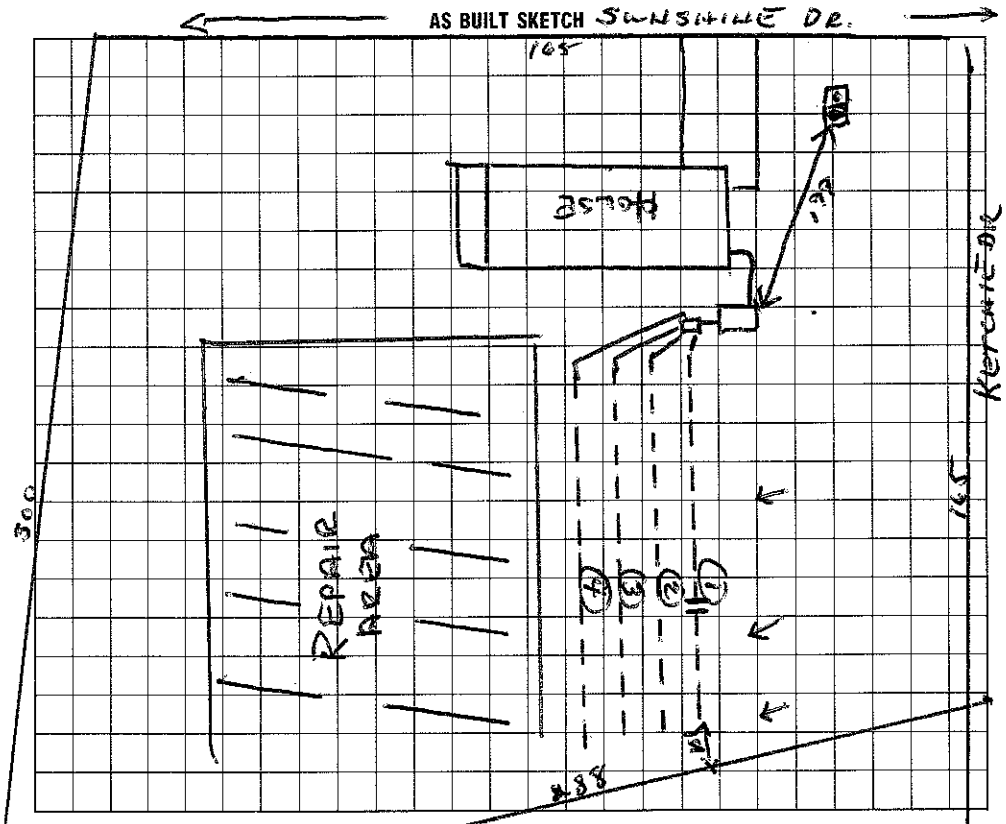

I understand that this permit can be suspended or revoked if any false information is supplied toward securing the permit/any unauthorized changes are made to the site/any unauthorized changes are made in the installation of the system. Improvement Permit is valid for 60 months from date of issuance.

Signed: _____

Improvement Permit by: _____ date _____

Existing System Inspection by: _____ date _____

Installed by: Kurt Dingis

Certificate of Completion by: Wesley Sparks date 6/25/93

Operation Permit by: Wesley Sparks AWS date ~~6/25/93~~

HEALTH DEPT. COPY: WHITE INSPECTION COPY (FINAL): GREEN OWNER COPY (FINAL): YELLOW INSPECTION COPY (INITIAL): PINK OWNER COPY (INITIAL): GOLD