IREDELL COUNTY HEALTH DEPARTMENT

STATESVILLE 704-878-5305 MOORESVILLE 704-664-5281

IMPROVEMENT PERMIT / CERTIFICATE OF COMPLETION / OPERATION PERMIT / EXISTING SYSTEM INSPECTION

PROPERTY DESCRIPTION NO. 2357 DATE 6/24/93 TAX MAP NO. 1M16B19

OWNER OR CONTRACTOR BROADMOOR HOMES PHONE: Business 663-7660 Home

ADDRESS PO BOX 1242 MOORESVILLE, NC. 4657693219

LOCATION KETCHIE DR, TL OFF RINEHART RD, TO (R) CORNER HOUSE AT INTERSECTION

SUBDIVISION SUNSHINE EST. BLOCK / SECTION 1 LOT 19 LOT AREA .98 SITE CLASS. P L.T.A.R. .25

Water Supply: ☑ Individual ☐ Community ☐ Public

Septic Tank: 1000 Gallons; STB 825 Date 6-5-93

Pump Tank: Gallons; PT Date

Nitrification Field: No Fields 1 Square Feet 1440 Linear Feet 480

No Lines 4 Trench Width 36" Trench Depth 36" Gravel Depth 12"

☑ New System ☐ Repair System Type: I, II, III, IV, V, VI

System Description: CONV.

Repair System Description: CONV.

Maintenance Agreement Required: ☐ Yes ☑ No

☑ House/Mod. Home No. Bedrooms 3 Garbage Disposal: ☐ Yes ☑ No

☐ Mobile Home No. Bathrooms 2 Auto. Dishwasher: ☑ Yes ☐ No


☐ Business No. Employees Auto. Washing Machine: ☑ Yes ☐ No

☐ Other Other

☐ Slab ☑ Crawl Space ☐ Basement w/plumbing ☐ Basement wo/plumbing

Comments TRENCHES ON SLOPE CONTOUR (TRICKY) - NO DEEPER THAN 36" TO TRENCH BOTTOM. WELL LOCATED AT LEAST 50' FROM ALL PARTS OF SEPTIC TANK SYSTEM.

INITIAL SITE SKETCH

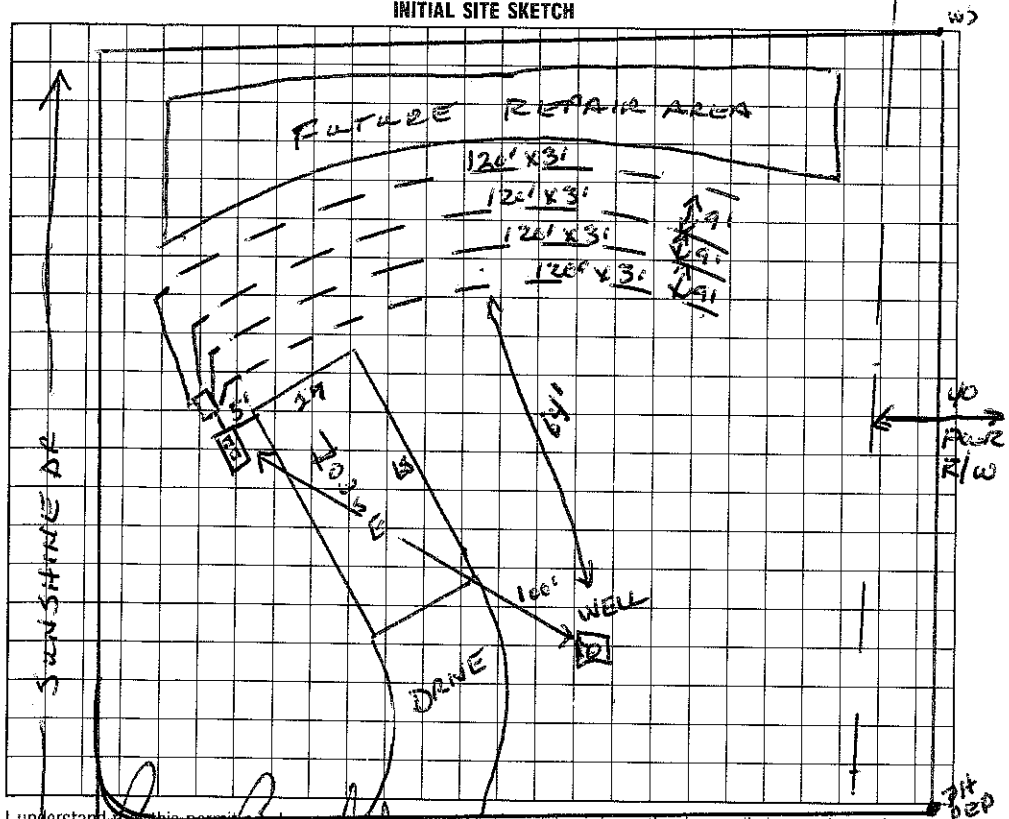

AS BUILT SKETCH

Installed as drawn - Ames

I understand that this permit can be suspended or revoked if any false information is supplied toward securing the permit/any unauthorized changes are made to the site/any unauthorized changes are made in the installation of the system. Improvement Permit is valid for 60 months from date of issuance. KETCHIE DR.

Signed:

Improvement Permit by: Wesley Sparks RS. date 6/24/93

Existing System Inspection by: date

Installed by: Curt Dunning

Certificate of Completion by: Wesley Sparks RS date 7/23/93

Operation Permit by: date

HEALTH DEPT. COPY: WHITE INSPECTION COPY (FINAL): GREEN OWNER COPY (FINAL): YELLOW INSPECTION COPY (INITIAL): PINK OWNER COPY (INITIAL): GOLD